

MISSISSIPPI DEPARTMENT OF NATURAL RESOURCES

Bureau of Land and Water Resources

Southport Mall

P.O. Box 10631

Jackson, Mississippi 39209

WATER WELL DRILLERS LOG

CODED

WASHINGTON

D G 215

6-7-85

date well completed

IRRIGATION Equipment

firm name

WASHINGTON

county well located

LANDOWNER: Weissinger and

WYNW FARMS Rt. 2, Box 821

Greenville, MS

Water Drive Pivot (mailing address)

description of formations encountered

from

to

FINE SAND

0

40

COURSE SAND / pea gravel

40

83

WELL LOCATION:

sec. 11 T. 17 N. R. 8 S. E. W. of Greenville
 6 miles SW of Greenville
 (distance) (direction) (nearest town)

WELL PURPOSE: Pivot
 (home, irrigation, municipal, industrial)

WELL COMPLETION DATA:

- (1) diameter (inches) 12"
- (2) total depth (feet) 83
- (3) static water level (feet) 12 below above top of ground.
- (4) casing steel, 43' (material), (depth)
- (size) if telescope see back.
- (5) screen 40, 43' (length), (depth to top)
- 12" steel (size), (material)
- (6) pump 80, 750 (HP), (yield gpm)
- Diesel (type power)
- (7) electric log NO (yes or no)

(organization running log)

(8) how well bottom plugged steel plate

CODED

RECEIVED
 JUN 21 1985


DRILLERS REMARKS:

Department of Natural Resources
 Bureau of Land & Water Resources

If well telescopes please sketch and show depths.

IRRIGATION EQUIPMENT.
601/887-2555
INDIANOLA, MS

GROUND LEVEL

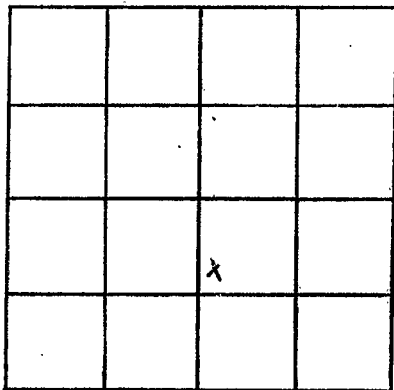

SECTION 11

Please indicate well location X.

ADDITIONAL INFORMATION

If more than one screen,
show locations of each on sketch.