

MISSISSIPPI DEPARTMENT OF NATURAL RESOURCES

Bureau of Land and Water Resources

Southport Mall

P.O. Box 10631

Jackson, Mississippi 39209

WATER WELL DRILLERS LOG

CODED

WASHINGTON
G216
10-16-85

10-16-85
date well completed

IRRIGATION EQUIPMENT
firm name

WASHINGTON
county well located

LANDOWNER: JAMES DYCEUS
Rt. 2, BOX M-69 Greenville,
MS 38701
(mailing address)

description of formations
encountered

from to

CLAY	0	50
FINE SAND	50	55
COARSE SAND / pea gravel	55	80

WELL LOCATION:

sec. 26 T 17 N R 8 E
S W
5 miles south of Greenville
(distance) (direction) (nearest town)

WELL PURPOSE: FISH POND
(home, irrigation, municipal, industrial)


WELL COMPLETION DATA:

- (1) diameter (inches) 16
- (2) total depth (feet) 80
- (3) static water level (feet) 17 below above top of ground.
- (4) casing PVC 40' (material) (depth)
- (size) if telescope see back.
- (5) screen 40' 40' (length) (depth to top)
- 16' PVC (size) (material)
- (6) pump 10 650 (HP) (yield gpm)
- Electric (type power)
- (7) electric log NO (yes or no)

(organization running log)

(8) how well bottom plugged PVC CAP

DRILLERS REMARKS:

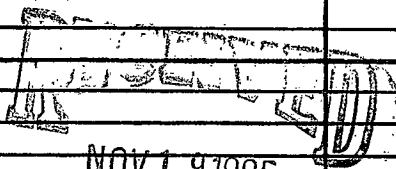


NOV 19 1985

Department of Natural Resources
Bureau of Land & Water Resources

If well telescopes please sketch and show depths.

IRRIGATION EQUIPMENT
601/887-2555
INDIANOLA, MS

GROUND LEVEL

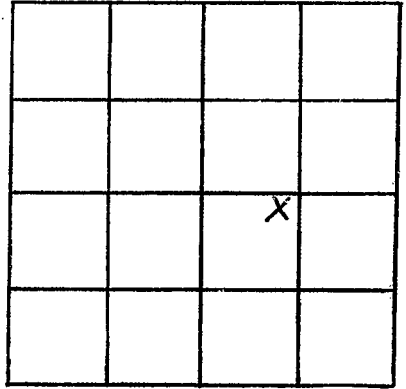

SECTION 26

Please indicate well location X.

ADDITIONAL INFORMATION

If more than one screen,
show locations of each on sketch.