

MISSISSIPPI DEPARTMENT OF NATURAL RESOURCES

Bureau of Land and Water Resources

Southport Mall

P.O. Box 10631

Jackson, Mississippi 39209

WATER WELL DRILLERS LOG

86114KSE01
 WASHINGTON
 G220

ED

CODED

5-1-86, 19 date well completed

Schultz Drilling firm name

Washington county well located

LANDOWNER: FRED BALLARD

Hwy 61 S

Leland, MS

(mailing address)

description of formations encountered

from

to

CLAY
 SAND

0
 25

25
 83

WELL LOCATION:


sec. 38 T. 17 S. R. 8 E.
 5 miles W of Arcola

WELL PURPOSE: IRRIGATION
 (home, irrigation, municipal, industrial)

WELL COMPLETION DATA:

- (1) diameter (inches) 10"
- (2) total depth (feet) 83'
- (3) static water level (feet) 30' below top of ground.
- (4) casing PVC, 63' (material), (depth)
- (size) If telescope see back.
- (5) screen 20' 63' (length), (depth to top)
- 10' PVC (size), (material)
- (6) pump 15 800 (HP), (yield gpm)
- ele (type power)
- (7) electric log no (yes or no)
- (organization running log)
- (8) how well bottom plugged CAP

CODED

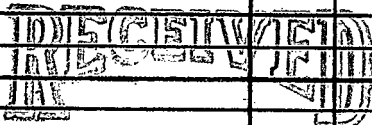


MAY 20 1986

Department of Natural Resources
 Bureau of Land & Water Resources

DRILLERS REMARKS:

If well telescopes please
sketch and show depths.

GROUND LEVEL

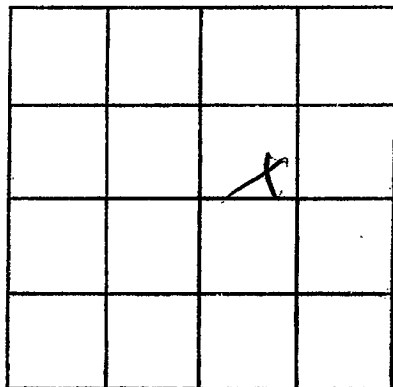

SECTION 38

Please indicate well location X.

ADDITIONAL INFORMATION

If more than one screen,
show locations of each on sketch.