

MISSISSIPPI DEPARTMENT OF NATURAL RESOURCES

Bureau of Land and Water Resources

Southport Mall

P.O. Box 10631

Jackson, Mississippi 39209

WATER WELL DRILLERS LOG

CODED

06083KSE01
 WASHINGTON
 CG 221

4-4-86, Schultz Drilling Washington
 date well completed firm name county well located

LANDOWNER: Paul WATSON

P.O. Box 4618

Greenville MS

(mailing address)

description of formations encountered

from

to

CLAY SAND

0 24
 24 85

WELL LOCATION:


sec. 37 T 17 S R 8 E WAYSIDE
 2 miles NW of (distance) (direction) (nearest town)

WELL PURPOSE: IRRIGATION
 (home, irrigation, municipal, industrial)

WELL COMPLETION DATA:

- (1) diameter (inches) 10"
- (2) total depth (feet) 85'
- (3) static water level (feet) 20' below top of ground.
- (4) casing PVC 65' (material) (depth)
- (size) if telescope see back.
- (5) screen 20' 65' (length) (depth to top)
- 10" PVC (size) (material)
- (6) pump 15' 750 (HP) (yield gpm)
- ele. (type power)
- (7) electric log NO (yes or no)
- X (organization running log)
- (8) how well bottom plugged CAP

CODED

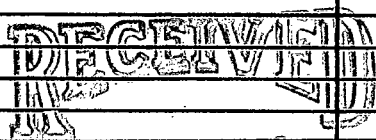


MAY 21 1986

DRILLERS REMARKS:

If well telescopes please sketch and show depths.

GROUND LEVEL

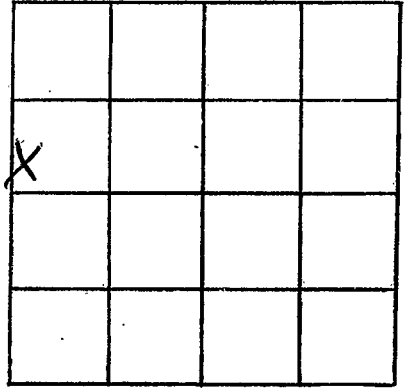

SECTION 37

Please indicate well location X.

ADDITIONAL INFORMATION

If more than one screen,
show locations of each on sketch.