

WASHINGTON  
G-224

MISSISSIPPI DEPARTMENT OF NATURAL RESOURCES  
Bureau of Land and Water Resources  
Southport Mall  
P.O. Box 10631  
Jackson, Mississippi 39209  
WATER WELL DRILLERS LOG

CODE:

6-15-1987 Schultz Drilling Washington  
date well completed firm name county well located

LANDOWNER: Leon Lumley  
Rt. 2 Box 635  
Grenville Mo. 38701  
(mailing address)

description of formations encountered	from	to
	CLAY	0
SAND	20	60
SAND + PEAGRAVEL	60	80

WELL LOCATION:  
sec. 28 T 17 N R. 8 E  
5 S S of Grenville  
(distance) (direction) (nearest town)

WELL PURPOSE: IRRIGATION  
(home, irrigation, municipal, industrial)

- WELL COMPLETION DATA:
- (1) diameter (inches) 10"
  - (2) total depth (feet) 80'
  - (3) static water level (feet) 32' below top of ground.
  - (4) casing PVC, 60' (material), (depth)  
if telescope see back.
  - (5) screen 20' 60' (length), (depth to top)  
10" (size), PVC (material)
  - (6) pump 15 (HP), 750 (yield gpm)  
ele. (type power)
  - (7) electric log NO (yes or no)  
X (organization running log)
  - (8) how well bottom plugged CAP

DRILLERS REMARKS:


RECEIVED

OCT 05 1987

Department of Natural Resources  
Bureau of Land & Water Resources

If well telescopes please sketch and show depths.

GROUND LEVEL

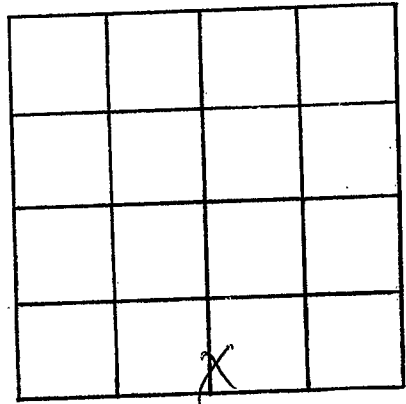

SECTION 28

Please indicate well location X.

ADDITIONAL INFORMATION

If more than one screen,  
show locations of each on sketch.