

MISSISSIPPI DEPARTMENT OF NATURAL RESOURCES

Bureau of Land and Water Resources

Southport Mall

P.O. Box 10631

Jackson, Mississippi 39209

WATER WELL DRILLERS LOG

WASHINGTON
G 227
145D

Coded

8-5 1987 Schultz Drilling WASHINGTON
date well completed firm name county well located

LANDOWNER: MARC CURTIS
P.O. 958
Leland MS
(mailing address)

description of formations encountered	from	to
CLAY	0	35
SAND	35	60
SAND + Pea gravel	60	80

WELL LOCATION:
sec. 32 T 17 N R 8 E
S S S W
5 miles S of Greenville
(distance) (direction) (nearest town)

WELL PURPOSE:
(home, irrigation, municipal, industrial)

WELL COMPLETION DATA:

(1) diameter (inches) 8"

(2) total depth (feet) 80'

(3) static water level (feet) 35' below top of ground.

(4) casing PVC 60' (material) (depth)

(size) If telescope see back.

(5) screen 20' 60' (length) (depth to top)
8" PVC (size) (material)

(6) pump 15 700 (HP) (yield gpm)
ele (type power)

(7) electric log NO (yes or no)
X (organization running log)

(8) how well bottom plugged CAP

RECEIVED


OCT 28 1987

Department of Natural Resources
Bureau of Land & Water Resources

DRILLERS REMARKS:

If well telescopes please sketch and show depths.

GROUND LEVEL

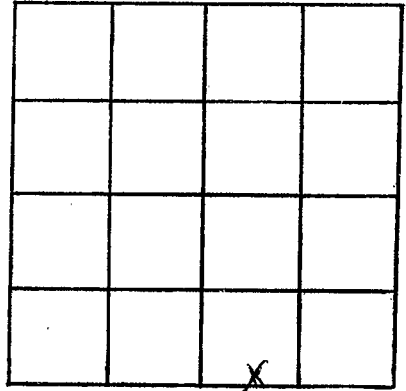

SECTION 32

Please indicate well location X.

ADDITIONAL INFORMATION

If more than one screen,
show locations of each on sketch.