

MISSISSIPPI DEPARTMENT OF NATURAL RESOURCES

Bureau of Land and Water Resources

Southport Mall

P.O. Box 10631

Jackson, Mississippi 39209

WATER WELL DRILLERS LOG

WASHINGTON
G 228
145D

Coded

8-10 1987 Schultz Drilling WASHINGTON
 date well completed firm name county well located

LANDOWNER: Highland Plantation
HWY 82W
Greenville MS
 (mailing address)

description of formations encountered	from	to
<u>CLAY</u>	<u>0</u>	<u>20</u>
<u>SAND</u>	<u>20</u>	<u>60</u>
<u>SAND + GRAVEL</u>	<u>60</u>	<u>87</u>

WELL LOCATION:
 sec. 14 T. 17 N. R. 8 E.
3 miles S of Greenville
 (distance) (direction) (nearest town)

WELL PURPOSE:
 (home, irrigation, municipal, industrial)

WELL COMPLETION DATA:

- (1) diameter (inches) 16"
- (2) total depth (feet) 87'
- (3) static water level (feet) 34 = below above top of ground.
- (4) casing PVC, 77'
 (material) (depth)
- _____ If telescope see back.
 (size)
- (5) screen 20', 77'
 (length) (depth to top)
16", Steel
 (size) (material)
- (6) pump 40, 1500
 (HP) (yield gpm)
p to
 (type power)
- (7) electric log NO
 (yes or no)
X
 (organization running log)
- (8) how well bottom plugged plate

RECEIVED


OCT 28 1987

Department of Natural Resources
 Bureau of Land & Water Resources

DRILLERS REMARKS:

If well telescopes please sketch and show depths.

GROUND LEVEL

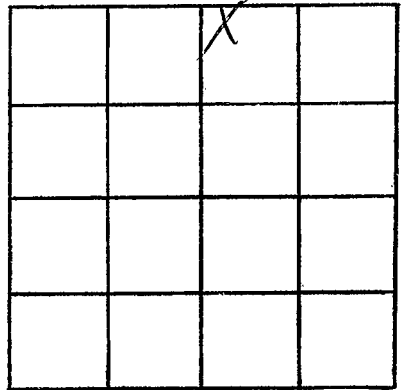

SECTION 14

Please indicate well location X.

ADDITIONAL INFORMATION

If more than one screen, show locations of each on sketch.