

MISSISSIPPI DEPARTMENT OF NATURAL RESOURCES

Bureau of Land and Water Resources

Southport Mall

P.O. Box 10631

Jackson, Mississippi 39209

WATER WELL DRILLERS LOG

WASHINGTON
G 229
145 D

Coded

8-10 1987
 date well completed

Schwartz Drilling
 firm name

WASHINGTON
 county well located

LANDOWNER: Highland Plantation
 Hwy 82 W
Greenville, MS
 (mailing address)

description of formations encountered	from	to
	<u>CLAY SAND</u>	<u>0</u> <u>30</u>

WELL LOCATION:
 sec. B T. 17 N. R. 8 E
3 miles S of Greenville
 (distance) (direction) (nearest town)

WELL PURPOSE:
 (home, irrigation, municipal, industrial)

- WELL COMPLETION DATA:
- (1) diameter (inches) 16"
 - (2) total depth (feet) 90'
 - (3) static water level (feet) 33' below above top of ground.
 - (4) casing PVC 70'
 (material) (depth)
 (size) if telescope see back.
 - (5) screen 20' 70'
 (length) (depth to top)
16" steel
 (size) (material)
 - (6) pump 210 1500
 (HP) (yield gpm)
pto
 (type power)
 - (7) electric log NO
 (yes or no)
X
 (organization running log)
 - (8) how well bottom plugged plate

RECEIVED


OCT 28 1987

Department of Natural Resources
 Bureau of Land & Water Resources

DRILLERS REMARKS:

If well telescopes please sketch and show depths.

GROUND LEVEL

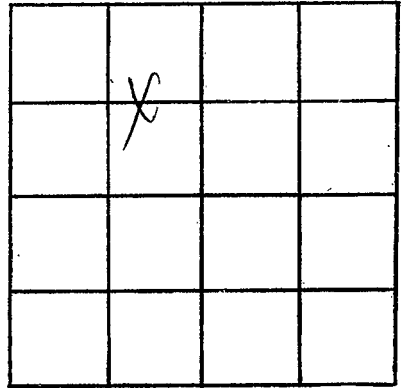

SECTION 13

Please indicate well location X.

ADDITIONAL INFORMATION

If more than one screen, show locations of each on sketch.