

MISSISSIPPI DEPARTMENT OF NATURAL RESOURCES

Bureau of Land and Water Resources

Southport Mall

P.O. Box 10631

Jackson, Mississippi 39209

WATER WELL DRILLERS LOG

WASHINGTON
G-232

CODED

5-31-88 date well completed Scholtz Drilling firm name Washington county well located

LANDOWNER: Highland Plantation	description of formations encountered	from	to
Rt. 4, Box 305			
Monroville Dr 38721 (mailing address)	MEDIUM SAND	37	70
	SAND + pea gravel	70	83
WELL LOCATION:			
sec. 14 T. 10 N. R. 8 E. S. 5 of Groveville			
Y4 miles (distance) S (direction) of Groveville (nearest town)			
WELL PURPOSE: IRRIGATION (home, irrigation, municipal, industrial)			
WELL COMPLETION DATA:			
(1) diameter (inches) 10"			
(2) total depth (feet) 83'			
(3) static water level (feet) 33 below top of ground.			
(4) casing PVC 63' (material), (depth)			
(size) If telescope see back.			
(5) screen 20' 63' (length), (depth to top)			
10' PVC (size), (material)			
(6) pump 15 800 (HP), (yield gpm)			
ele (type power)			
(7) electric log NO (yes or no)			
(organization running log) X			
(8) how well bottom plugged CAP			

RECEIVED


JUN 16 1988

Department of Natural Resources
Bureau of Land & Water Resources

DRILLERS REMARKS:

If well telescopes please sketch and show depths.

GROUND LEVEL

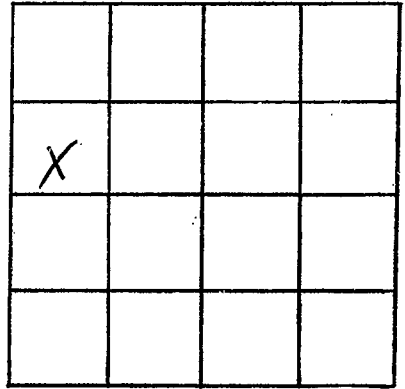

SECTION 14

Please indicate well location X.

ADDITIONAL INFORMATION

If more than one screen, show locations of each on sketch.