

MISSISSIPPI DEPARTMENT OF NATURAL RESOURCES

Bureau of Land and Water Resources

Southport Mall

P.O. Box 10631

Jackson, Mississippi 39209

WATER WELL DRILLERS LOG

WASHINGTON
G 233

CODED

5-31 1988 Schultz Drilling Washington
date well completed firm name county well located

LANDOWNER: Highland Plantation Rt. 4 Box 305	description of formations encountered	from	to
Greenville 38701 (mailing address)	CLAY SAND SAND + pea gravel	0 38 70	38 70 80
WELL LOCATION: sec. 14 T. 170 N R. 8 E V4 S of Greenville (distance) (direction) (nearest town)			
WELL PURPOSE: IRRIGATION (home, irrigation, municipal, industrial)			
WELL COMPLETION DATA:			
(1) diameter (inches) 10"			
(2) total depth (feet) 80'			
(3) static water level (feet) 33' -below above top of ground.			
(4) casing PVC 60 (material) (depth)			
_____ if telescope see back. (size)			
(5) screen 20' 60' (length) (depth to top)			
10" PVC (size) (material)			
(6) pump 15 800 (HP) (yield gpm)			
ele (type power)			
(7) electric log NO (yes or no)			
X (organization running log)			
(8) how well bottom plugged CAP			
DRILLERS REMARKS:			


RECEIVED

JUN 16 1988

Department of Natural Resources
Bureau of Land & Water Resources

If well telescopes please sketch and show depths.

GROUND LEVEL

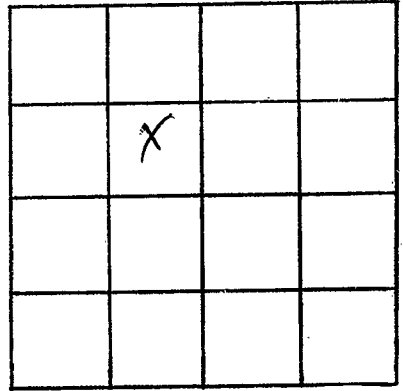

SECTION 14

Please indicate well location X.

ADDITIONAL INFORMATION

If more than one screen,
show locations of each on sketch.