

MISSISSIPPI DEPARTMENT OF NATURAL RESOURCES

Bureau of Land and Water Resources

Southport Mall

P.O. Box 10631

Jackson, Mississippi 39209

WATER WELL DRILLERS LOG

WASHINGTON
G-234

CODED

6-4 1988 Schultz Drilling Washington
date well completed firm name county well located

LANDOWNER: Percy Bell
Highland Plantation
Greenville, MS
(mailing address)

description of formations encountered	from	to
FINE SAND	0	30
MED SAND	30	70
COARSE SAND	70	85

WELL LOCATION:
sec. 15 T 17 N R 9 E
3 miles S of Greenville
(distance) (direction) (nearest town)

WELL PURPOSE: IRRIGATION
(home, irrigation, municipal, industrial)

WELL COMPLETION DATA:

(1) diameter (inches) 10"

(2) total depth (feet) 85'

(3) static water level (feet) 31' below above top of ground.

(4) casing PVC 65'
(material) (depth)

(5) screen 20' 65'
(length) (depth to top)
10" PVC
(size) (material)

(6) pump 15 800
(HP) (yield gpm)
ele (type power)

(7) electric log No
(yes or no)
X
(organization running log)

(8) how well bottom plugged CAP

RECEIVED


JUN 16 1988

Department of Natural Resources
Bureau of Land & Water Resources

DRILLERS REMARKS:

If well telescopes please
sketch and show depths.

GROUND LEVEL

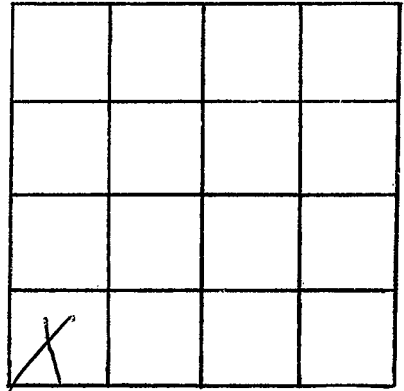

SECTION 15

Please indicate well location X.

ADDITIONAL INFORMATION

If more than one screen,
show locations of each on sketch.