

MISSISSIPPI DEPARTMENT OF NATURAL RESOURCES

Bureau of Land and Water Resources

Southport Mall

P.O. Box 10631

Jackson, Mississippi 39209

WATER WELL DRILLERS LOG

WASHINGTON  
G-235

CODED

5-20 1988 date well completed  
Schultz Drilling firm name  
Washington county well located

LANDOWNER: MARK POTTER	description of formations encountered	from	to
Rt. 1 Box P51	CLAY	0	24
Leland MS	FINE SAND	24	30
(mailing address)	CLAY	30	50
WELL LOCATION:	COARSE SAND	50	86
sec. 37 T 17 N R 8 E 1 miles E of Wayside (distance) (direction) (nearest town)			
WELL PURPOSE: IRRIGATION (home, irrigation, municipal, industrial)			
WELL COMPLETION DATA:			
(1) diameter (inches) 10"			
(2) total depth (feet) 86'			
(3) static water level (feet) 30 below top of ground.			
(4) casing PVC 66' (material) (depth)			
If telescope see back.			
(5) screen 20' 66' (length) (depth to top)			
(6) pump 10" 30 (size) (HP) PVC 1000 (material) (yield gpm)			
pto (type power)			
(7) electric log NO (yes or no)			
(organization running log) X			
(8) how well bottom plugged CAP			

RECEIVED


JUN 16 1988

Department of Natural Resources  
Bureau of Land & Water Resources

DRILLERS REMARKS:

If well telescopes please sketch and show depths.

GROUND LEVEL

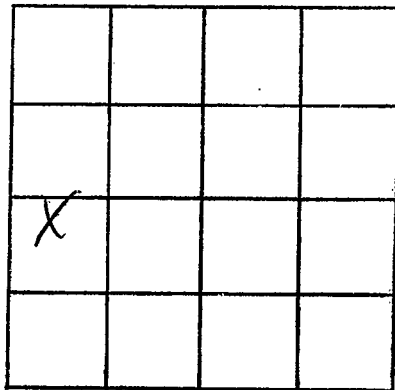

SECTION 37

Please indicate well location X.

ADDITIONAL INFORMATION

If more than one screen,  
show locations of each on sketch.