

MISSISSIPPI DEPARTMENT OF NATURAL RESOURCES

CODED

Bureau of Land and Water Resources

Southport Mall

P.O. Box 10631

Jackson, Mississippi 39209

WATER WELL DRILLERS LOG

G 236
 WASHINGTON

5-25 1988
 date well completed

Schutz Drilling
 firm name

Washington
 county well located

| LANDOWNER: Johnny Griffin 1150 Canal Ave. Greenville MS 38701 (mailing address) | description of formations encountered | from | to |
|---|---------------------------------------|---------------|----------------|
| WELL LOCATION: sec 21 T 17 N R 9 E 4 miles S of Greenville (distance) (direction) (nearest town) | CLAY SAND SAND + GRAVEL | 0 20 70 | 20 70 90 |
| WELL PURPOSE: IRRIGATION (home, irrigation, municipal, industrial) | | | |
| WELL COMPLETION DATA: | | | |
| (1) diameter (inches) 4" | | | |
| (2) total depth (feet) 90' | | | |
| (3) static water level (feet) 30 below top of ground | | | |
| (4) casing PVC 50' (material) (depth) | | | |
| If telescope see back. | | | |
| (5) screen 40' 50' (length) (depth to top) | | | |
| 4" PVC (size) (material) | | | |
| (6) pump 3 100 (HP) (yield gpm) | | | |
| ele (type power) | | | |
| (7) electric log NO (yes or no) | | | |
| X (organization running log) | | | |
| (8) how well bottom plugged CAP | | | |

RECEIVED


JUN 16 1988

Department of Natural Resources
 Bureau of Land & Water Resources

DRILLERS REMARKS:

If well telescopes please sketch and show depths.

GROUND LEVEL

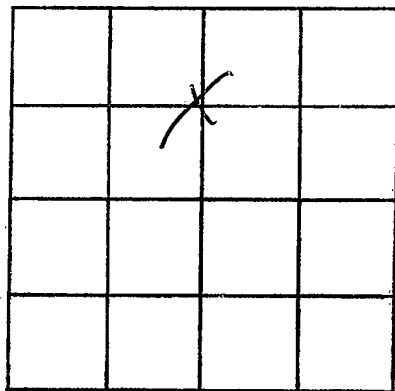

SECTION 21

Please indicate well location X.

ADDITIONAL INFORMATION

If more than one screen,
show locations of each on sketch.