

MISSISSIPPI DEPARTMENT OF NATURAL RESOURCES

Bureau of Land and Water Resources

Southport Mall

P.O. Box 10631

Jackson, Mississippi 39209

WATER WELL DRILLERS LOG

CODED

W. H. AINSWORTH  
Q 237

5-22-85 date well completed      Schultz Drilling firm name      WASH. county well located

LANDOWNER: MARCCURTIS  
Hwy 61  
Leland MS  
 (mailing address)

description of formations encountered

	from	to
<u>CLAY</u>	<u>0</u>	<u>24</u>
<u>SAND</u>	<u>24</u>	<u>80</u>

WELL LOCATION:  
 sec. 32 T. 17 N. R. 8 E  
6 miles S of 9ville  
 (distance) (direction) (nearest town)

WELL PURPOSE: IRRIGATION  
 (home, irrigation, municipal, industrial)

WELL COMPLETION DATA:

(1) diameter (inches) 10"  
 (2) total depth (feet) 80'  
 (3) static water level (feet) 36' below top of ground.  
 (4) casing PVC 60'  
 (material) (depth)  
 (size) if telescope see back.  
 (5) screen 20' 60'  
 (length) (depth to top)  
10" PVC  
 (size) (material)  
 (6) pump 15 800  
 (HP) (yield gpm)  
ele  
 (type power)  
 (7) electric log NO  
 (yes or no)  
 (organization running log)  
 (8) how well bottom plugged COA?

CODED

RECEIVED  
 DEC 3 - 1985


DRILLERS REMARKS:

Department of Natural Resources  
 Bureau of Land & Water Resources

If well telescopes please sketch and show depths.

GROUND LEVEL

1500'

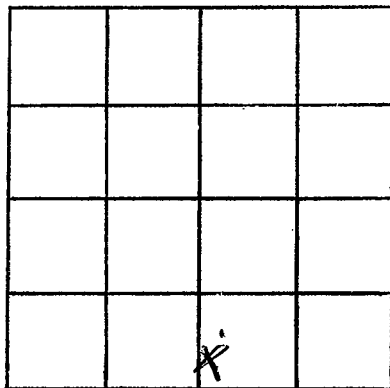

SECTION 32

Please indicate well location X.

ADDITIONAL INFORMATION

If more than one screen,  
show locations of each on sketch.