

MISSISSIPPI DEPARTMENT OF NATURAL RESOURCES

Bureau of Land and Water Resources

Southport Mall

P.O. Box 10631

Jackson, Mississippi 39209

WATER WELL DRILLERS LOG

CODED

WASHINGTON
G 238

5-20-85 date well completed Schultz Drilling firm name WASH. county well located


LANDOWNER: MARC CURTIS	description of formations encountered		from	to
Hwy 61.				
Leland, MS	CLAY		0	24
(mailing address)	SAND		24	83

WELL LOCATION:
sec. 32-17-8 S R-8 E
6 miles S of G'ville
(distance) (direction) (nearest town)

WELL PURPOSE: Irrigation
(home, irrigation, municipal, industrial)

CODED

- WELL COMPLETION DATA:
- (1) diameter (inches) 10^{cr}
 - (2) total depth (feet) 83'
 - (3) static water level (feet) 36' below top of ground.
 - (4) casing PVC 63', (depth)
 - (size) if telescope see back.
 - (5) screen 20 83 (length) (depth to top)
 - 10 PVC (size) (material)
 - (6) pump 20 1000 (HP) (yield gpm)
 - ele (type power)
 - (7) electric log no (yes or no)
 - X (organization running log)
 - (8) how well bottom plugged CAP

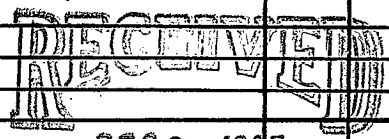


DEC 3 - 1985

DRILLERS REMARKS:

If well telescopes please sketch and show depths.

GROUND LEVEL

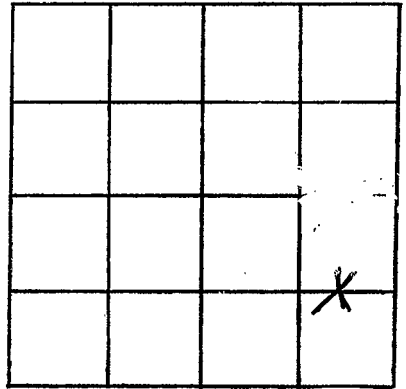

SECTION 32

Please indicate well location X.

ADDITIONAL INFORMATION

If more than one screen, show locations of each on sketch.