

MISSISSIPPI DEPARTMENT OF NATURAL RESOURCES

Bureau of Land and Water Resources

Southport Mall

P.O. Box 10631

Jackson, Mississippi 39209

WATER WELL DRILLERS LOG

CODED

WASHINGTON
G 239

8-9 1985 date well completed Schultz Drilling firm name Wash county well located

LANDOWNER: FRED BALLARD
HWY 61 S
Leland MS
(mailing address)

description of formations encountered	from	to
<u>CLAY</u>	<u>0</u>	<u>26</u>
<u>SAND</u>	<u>26</u>	<u>85</u>

WELL LOCATION:
sec 38 T 17 N R 8 E
S S S
8 miles S of Guille
(distance) (direction) (nearest town)

WELL PURPOSE: IRRIGATION
(home, irrigation, municipal, industrial)

CODED

- WELL COMPLETION DATA:
- (1) diameter (inches) 10"
 - (2) total depth (feet) 85'
 - (3) static water level (feet) 37' below above top of ground.
 - (4) casing PVC 85'
(material) (depth)
 - _____ If telescope see back.
(size)
 - (5) screen 20' 65'
10" (length) (depth to top)
(size) PVC (material)
 - (6) pump 20 1000
(HP) (yield gpm)
 - ele
(type power)
 - (7) electric log NO
(yes or no)
Y
(organization running log)
 - (8) how well bottom plugged CAP

RECEIVED


DEC 2 - 1985

DRILLERS REMARKS:

Department of Natural Resources
Bureau of Land & Water Resources

If well telescopes please sketch and show depths.

GROUND LEVEL

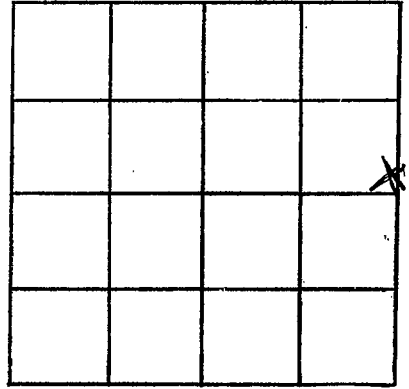

SECTION 38

Please indicate well location X.

ADDITIONAL INFORMATION

If more than one screen, show locations of each on sketch.