

MISSISSIPPI DEPARTMENT OF NATURAL RESOURCES

Bureau of Land and Water Resources

Southport Mall

P.O. Box 10631

Jackson, Mississippi 39209

WATER WELL DRILLERS LOG

CODED

WASHINGTON
G 240

8-8-85 Schultz Drilling WASH.
date well completed firm name county well located

LANDOWNER: FRED BALLARD	description of formations encountered		from	to
Hwy 61 S	CLAY		0	25
Leland, MS	SAND		25	85
(mailing address)				
WELL LOCATION:				
sec. 38 T-17 N R-8 E				
8 miles S of Gville				
(distance) (direction) (nearest town)				
WELL PURPOSE: IRRIGATION				
(home, irrigation, municipal, industrial)				
WELL COMPLETION DATA:				
(1) diameter (inches) 10"				
(2) total depth (feet) 85'				
(3) static water level (feet) 37' below top of ground.				
(4) casing PVC, 65' (material) (depth)				
(size) if telescope see back.				
(5) screen 20' 65' (length) (depth to top)				
10" PVC (size) (material)				
(6) pump 20 HP 1000 (type power) (yield gpm)				
(7) electric log no (yes or no)				
(organization running log) X				
(8) how well bottom plugged CAP				
DRILLERS REMARKS:				

CODED


RECEIVED

DEC 6 1985

Department of Natural Resources
Bureau of Land & Water Resources

If well telescopes please sketch and show depths.

GROUND LEVEL

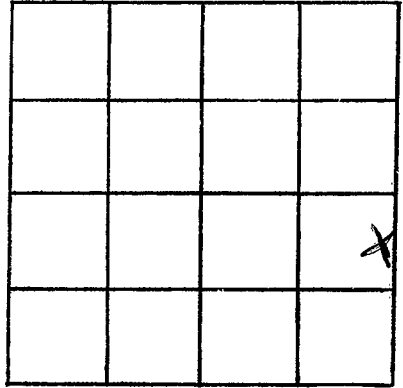

SECTION 38

Please indicate well location X.

ADDITIONAL INFORMATION

If more than one screen,
show locations of each on sketch.