

MISSISSIPPI DEPARTMENT OF NATURAL RESOURCES

Bureau of Land and Water Resources

Southport Mall

P.O. Box 10631

Jackson, Mississippi 39209

WATER WELL DRILLERS LOG

CODED

WASHINGTON  
G-241

3-12-19 date well completed Schultz Drilling firm name Washington county well located

LANDOWNER: THAD POTTER HWY - 438 Greenville, MS (mailing address)	description of formations encountered	from	to
	CLAY	0	20
	SAND	20	78
WELL LOCATION: sec. 37-T-110 S R-8 E 8 miles S of Quille (distance) (direction) (nearest town)			
WELL PURPOSE: IRRIGATION (home, irrigation, municipal, industrial)			
WELL COMPLETION DATA:			
(1) diameter (inches) 10"			
(2) total depth (feet) 78'			
(3) static water level (feet) 35' below above top of ground.			
(4) casing PVC 58' (material) (depth)			
(5) screen 20' 58' (size) (length) (depth to top)			
(6) pump 30 1000 (HP) (yield gpm)			
PTO (type power)			
(7) electric log NO (yes or no)			
X (organization running log)			
(8) how well bottom plugged CAP			

CODED


RECEIVED

DEC 3 - 1985

DRILLERS REMARKS:

If well telescopes please sketch and show depths.

GROUND LEVEL

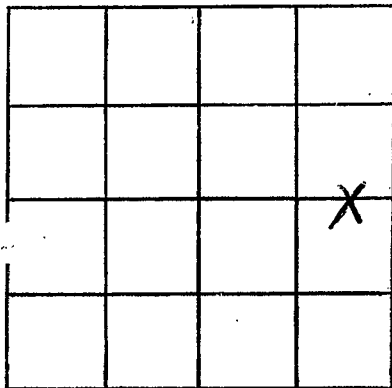

37

SECTION \_\_\_\_\_

Please indicate well location X.

ADDITIONAL INFORMATION

If more than one screen, show locations of each on sketch.