

MISSISSIPPI DEPARTMENT OF NATURAL RESOURCES

Bureau of Land and Water Resources

Southport Mall

P.O. Box 10631

Jackson, Mississippi 39209

WATER WELL DRILLERS LOG

CODED

#2
 WASH
 G 242

3-10, 85 Schultz Drilling WASHINGTON
 date well completed firm name county well located

LANDOWNER:	description of formations encountered	from	to
AQUA FARMS GREENVILLE MS (mailing address)			
WELL LOCATION: sec. 30 T. 17 N. R. 8 E 6 miles S of G'VILLE (distance) (direction) (nearest town)			
WELL PURPOSE: IRRIGATION (home, irrigation, municipal, industrial)			
WELL COMPLETION DATA:			
(1) diameter (inches) 10"			
(2) total depth (feet) 86'			
(3) static water level (feet) 35' below top of ground.			
(4) casing PVC, 66' (material) (depth)			
(size) if telescope see back.			
(5) screen 20', 66' 10" (length) (depth to top)			
(size) (material) PVC			
(6) pump 20 (HP), 1000 (yield gpm)			
(type power) ele			
(7) electric log NO (yes or no)			
(organization running log) X			
(8) how well bottom plugged CAP			
DRILLERS REMARKS:			


CODED

RECEIVED

DEC 3 - 1985

If well telescopes please sketch and show depths.

GROUND LEVEL

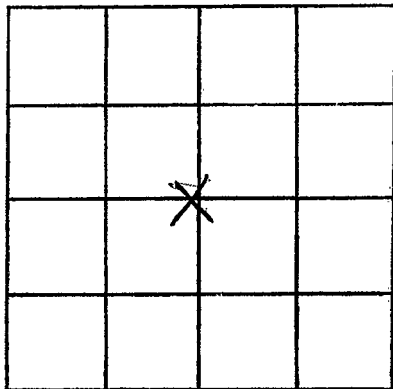

SECTION 30

Please indicate well location X.

ADDITIONAL INFORMATION

If more than one screen, show locations of each on sketch.