

MISSISSIPPI DEPARTMENT OF NATURAL RESOURCES

Bureau of Land and Water Resources

Southport Mall

P.O. Box 10631

Jackson, Mississippi 39209

WATER WELL DRILLERS LOG

CODED

#1  
 WASH  
 G 243

3-9-85 date well completed Schultz Drilling firm name Washington county well located

LANDOWNER:	description of formations encountered	from	to
AQUA FARMS GREENVILLE, MS (mailing address)		CLAY SAND	0 20
WELL LOCATION: sec. 30-T-17(N) S 6 miles (distance) R. 8 E of 9'ville (direction) (nearest town)			
WELL PURPOSE: IRRIGATION (home, irrigation, municipal, industrial)			
WELL COMPLETION DATA: (1) diameter (inches) 10" (2) total depth (feet) 86' (3) static water level (feet) 35' below top of ground. (4) casing PVC, 66' (material), (depth) (5) screen 20' 66' (length), (depth to top) 10" PVC (size), (material) (6) pump 20 1000 (HP), (yield gpm) ele (type power) (7) electric log NO (yes, or no) (organization fanning log) (8) how well bottom plugged CAP			

CODED


RECEIVED  
 DEC 3 - 1985

DRILLERS REMARKS:

Department of Natural Resources  
 Bureau of Land and Water Resources

If well telescopes please sketch and show depths.

GROUND LEVEL

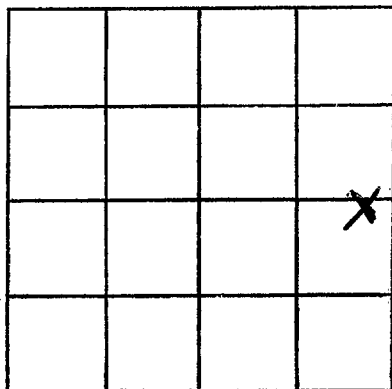

SECTION 30

Please indicate well location X.

ADDITIONAL INFORMATION

If more than one screen,  
show locations of each on sketch.