

MISSISSIPPI DEPARTMENT OF NATURAL RESOURCES

Bureau of Land and Water Resources

Southport Mall

P.O. Box 10631

Jackson, Mississippi 39209

WATER WELL DRILLERS LOG

CODED

WASHINGTON
G. 244

5-17-85 date well completed
Schultz Drilling firm name
Washington county well located

LANDOWNER: Allen Sprengins
Refuge Plantation
Greenville, MS
(mailing address)

description of formations encountered	from	to
CLAY	0	38
SAND	38	40

WELL LOCATION:
sec. 9 T. 17 N. R. 9 E. S. 7
7 miles S of Greenville
(distance) (direction) (nearest town)

WELL PURPOSE: IRRIGATION
(home, irrigation, municipal, industrial)

- WELL COMPLETION DATA:
- (1) diameter (inches) 16"
 - (2) total depth (feet) 110'
 - (3) static water level (feet) 29' below top of ground.
 - (4) casing PVC 90' (material) (depth)
16" (size) if telescope see back.
 - (5) screen 30' 90' (length) (depth to top)
16" (size) PVC (material)
 - (6) pump 40 2000 (HP) (yield gpm)
P10 (type power)
 - (7) electric log No (yes or no)
✓ (organization running log)
 - (8) how well bottom plugged CAP

CODED


RECEIVED
DEC 3 - 1985

DRILLERS REMARKS:

Department of Natural Resources
Bureau of Land & Water Resources

If well telescopes please sketch and show depths.

GROUND LEVEL

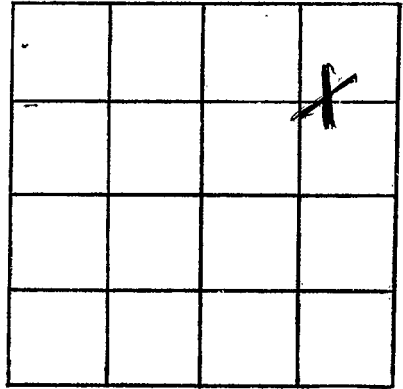

SECTION 9

Please indicate well location X.

ADDITIONAL INFORMATION

If more than one screen,
show locations of each on sketch.