

MISSISSIPPI DEPARTMENT OF NATURAL RESOURCES

Bureau of Land and Water Resources

Southport Mall

P.O. Box 10631

Jackson, Mississippi 39209

WATER WELL DRILLERS LOG

WATSON  
G 245

6-1-85 date well completed 19 85 Schultz Drilling firm name Wash. county well located


LANDOWNER: Paul Watson  
Hwy 82E  
Greenville, MS  
(mailing address)

description of formations encountered	from	to
<u>CLAY</u>	<u>0</u>	<u>28</u>
<u>SAND</u>	<u>28</u>	<u>90</u>

WELL LOCATION:  
sec. 37 T. 17 N. R. 8 E.  
6 miles S of Greenville  
(distance) (direction) (nearest town)

WELL PURPOSE: DELEGATION  
(home, irrigation, municipal, industrial)

- WELL COMPLETION DATA:
- (1) diameter (inches) 10"
  - (2) total depth (feet) 90'
  - (3) static water level (feet) 33' below above top of ground.
  - (4) casing PVC 70'  
(material) (depth)
  - (size) If telescope see back.
  - (5) screen 20" 70"  
(length) (depth to top)
  - 10 PVC  
(size) (material)
  - (6) pump 20 1000  
(HP) (yield gpm)
  - ele  
(type power)
  - (7) electric log NO  
(yes or no)
  - X  
(organization running log)
  - (8) how well bottom plugged cap

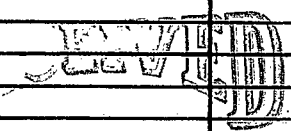


DEC 3 - 1985

DRILLERS REMARKS:

Department of Natural Resources  
Bureau of Land and Water Resources

If well telescopes please sketch and show depths.

GROUND LEVEL

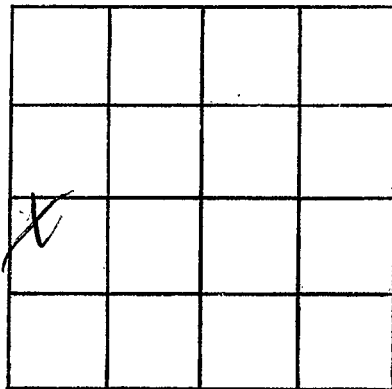

SECTION 37

Please indicate well location X.

ADDITIONAL INFORMATION

If more than one screen, show locations of each on sketch.