

MISSISSIPPI DEPARTMENT OF NATURAL RESOURCES

Bureau of Land and Water Resources

Southport Mall

P.O. Box 10631

Jackson, Mississippi 39209

WATER WELL DRILLERS LOG

CODED

WASHINGTON  
G 246

4-10 1985 Scholtz Drilling WASH.  
date well completed firm name county well located

LANDOWNER: Leon Lumley  
Pt. 2.  
Greenville MS  
(mailing address)

description of formations encountered	from to	
CLAY	0	40
SAND	40	85

WELL LOCATION:  
sec. 38 T 17 N R 8 E  
7 miles S of Greenville  
(distance) (direction) (nearest town)

WELL PURPOSE: IRRIGATION  
(home, irrigation, municipal, industrial)

WELL COMPLETION DATA:

(1) diameter (inches) 10"

(2) total depth (feet) 85'

(3) static water level (feet) 36' below top of ground.

(4) casing PVC 65'  
(material) (depth)  
(size) If telescope see back.

(5) screen 20' 65'  
(length) (depth to top)  
10" PVC  
(size) (material)

(6) pump 20 1000  
(HP) (yield gpm)  
ele  
(type power)

(7) electric log NO  
(yes or no)  
X  
(organization running log)

(8) how well bottom plugged CAP

CODED


RECEIVED  
DEC 3 - 1985

DRILLERS REMARKS:

Department of Natural Resources  
Bureau of Land and Water Resources

If well telescopes please sketch and show depths.

GROUND LEVEL

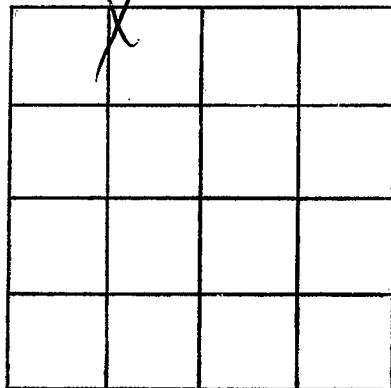

SECTION 38

Please indicate well location X.

ADDITIONAL INFORMATION

If more than one screen,  
show locations of each on sketch.