

MISSISSIPPI DEPARTMENT OF ENVIRONMENTAL QUALITY
Bureau of Land and Water Resources

P. O. Box 10631
Jackson, MS 39289-0631
WATER WELL DRILLERS LOG

COUNTY WELL LOCATED
Washington

WELL NUMBER 262 CODED

DATE WELL COMPLETED
7-16-91

145D

PERMIT NUMBER 4

NAME OF DRILLING FIRM
Schultz Drilling

NAME & MAILING ADDRESS OF LANDOWNER
Robert May

434 Idlewild Dr.

Greenville MS, 38701

WELL LOCATION: SEC 5 TOWNSHIP 17 RANGE 9

DISTANCE 8 Miles SW DIRECTION of Greenville NEAREST TOWN

OTHER LANDMARK
1/2 NE of Greenville Ark Bridge

WELL PURPOSE: Home, Irrigation, Municipal, Industrial, Fish Pond, etc.

PUMP DATA

PUMP TYPE (Circle One):
Submersible, Turbine Jet Flowing Well,
Other (Describe) _____

POWER TYPE (Circle One):
Electric Tractor, Diesel, Gasoline, Butane,
Other (Describe) _____ H/P _____

Pump Capacity (GPM) <u>2000</u>	No. of Stages <u>2</u>	Setting Depth <u>60</u> FT.
------------------------------------	---------------------------	--------------------------------

PUMP TEST

Well yielded _____ GPM with
a drawdown of _____ ft.
after _____ hours of pumping

WELL DATA

Well Depth <u>100ft</u>	Casing Diameter (In.) <u>16</u>	Casing Length (Ft.) <u>60</u>
Type of Casing <u>steel</u>	Hole Depth <u>100ft</u>	Depth to Static Water Level <u>9</u>

TYPE OF COMPLETION: (Circle One or More):
Gravel Packed, Underreamed, Telescoped,
Natural Development, Open Hole, Other

(Describe) Hole plug

Top of Lap Pipe or Reduction in Casing

FEET IF TELESCOPED OR MORE THAN ONE SCREEN: USE BACK PAGE

LOG DATA

TYPE OF LOG RUN (Circle One):
Electric, Gamma Ray, Density, Sonic, No Log Run, Neutron,
Other (Describe) _____

Name of Organization Running Log

SCREEN DATA

Diameter - Inches <u>16</u>	Length - Feet <u>40</u>	Slot Size - Inches <u>.050</u>
Screen Type <u>steel</u>	Depth to Bottom - Feet <u>100</u>	

GEOLOGIC DATA (Office Use Only)

Surface Elev.	Geologic Unit	Unit Thickness	Depth to Top
Subs. SWL	Date	Analysis	Aquifer Test

Driller's Remarks

DESCRIPTION OF FORMATIONS ENCOUNTERED	FROM	TO
<u>Top soil</u>	<u>0</u>	<u>4</u>
<u>fine sand</u>	<u>4</u>	<u>35</u>
<u>med sand</u>	<u>35</u>	<u>50</u>
<u>course sand p.g.</u>	<u>50</u>	<u>100</u>

FORMATIONS (Continued)

REGISTERED


DEC 06 1991

Dept. of Environmental Quality
Bureau of Land & Water Resources

IF MORE SPACE IS NEEDED, USE BACK

If well telescopes please
sketch and show depths.

GROUND LEVEL

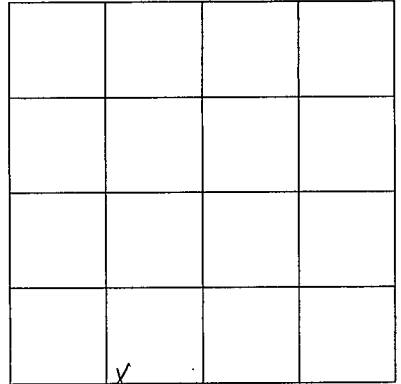

SECTION 5

Please indicate well location X.

ADDITIONAL INFORMATION

If more than one screen,
show location of each on sketch.