

MISSISSIPPI DEPARTMENT OF ENVIRONMENTAL QUALITY
Bureau of Land and Water Resources

P. O. Box 10631
Jackson, MS 39289-0631
WATER WELL DRILLERS LOG

COUNTY WELL LOCATED <u>Washington</u>	
WELL NUMBER <u>265</u>	CODED <input checked="" type="checkbox"/>
DATE WELL COMPLETED <u>11-1-92</u>	

PERMIT NUMBER
NAME OF DRILLING FIRM <u>Schudco Ltd</u>

NAME & MAILING ADDRESS OF LANDOWNER <u>Paul Oswald Jr.</u>			
<u>Lake Lee Rd.</u>			
<u>Greenville Ms 38701</u>			
WELL LOCATION:	SEC	TOWNSHIP	RANGE
	<u>12</u>	<u>17</u> ^N _S	<u>9</u> ^E _W
DISTANCE	DIRECTION	NEAREST TOWN	
<u>5</u> Miles	<u>SW</u>	of <u>Greenville</u>	
OTHER LANDMARK			
WELL PURPOSE <input checked="" type="checkbox"/> Home, Irrigation, Municipal, Industrial, Fish Pond, etc.			


PUMP DATA		
PUMP TYPE (Circle One): <input checked="" type="checkbox"/> Submersible, Turbine, Jet, Flowing Well, Other (Describe) _____		
POWER TYPE (Circle One): <input checked="" type="checkbox"/> Electric, Tractor, Diesel, Gasoline, Butane, Other (Describe) _____ H/P <u>1</u>		
Pump Capacity (GPM) <u>20</u>	No. of Stages <u>6</u>	Setting Depth <u>105</u> FT.
PUMP TEST		
Well-yielded _____ GPM with a drawdown of _____ ft. after _____ hours of pumping		

WELL DATA		
Well Depth <u>400</u>	Casing Diameter (In.) <u>4x2</u>	Casing Length (Ft.) <u>380</u>
Type of Casing <u>pvc</u>	Hole Depth <u>400</u>	Depth to Static Water Level <u>27</u>
TYPE OF COMPLETION: (Circle One or More): <input checked="" type="checkbox"/> Gravel Packed, Underreamed, Telescoped, <input checked="" type="checkbox"/> Natural Development, Open Hole, Other		
Top of Lap Pipe or Reduction in Casing		
FEET	IF TELESCOPED OR MORE THAN ONE SCREEN: USE BACK PAGE	

LOG DATA	
TYPE OF LOG RUN (Circle One): Electric, Gamma Ray, Density, Sonic, Neutron, Other (Describe) _____ <input checked="" type="checkbox"/> No Log Run	
Name of Organization Running Log	

SCREEN DATA		
Diameter - Inches <u>2 1/2</u>	Length - Feet <u>20</u>	Slot Size - Inches <u>.010</u>
Screen Type <u>pvc</u>	Depth to Bottom - Feet <u>400</u>	


GEOLOGIC DATA (Office Use Only)			
Surface Elev.	Geologic Unit	Unit Thickness	Depth to Top
Subs. SWL	Date	Analysis	Aquifer Test
Driller's Remarks			

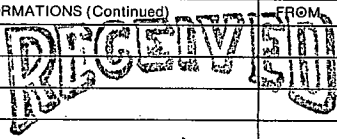DESCRIPTION OF FORMATIONS ENCOUNTERED	FROM	TO	FORMATIONS (Continued)	FROM	TO
<u>Top soil</u>	<u>10</u>	<u>10</u>	 MAR 11 1993 Dept. of Environmental Quality Office of Land & Water Resources		
<u>sand + gravel</u>	<u>10</u>	<u>115</u>			
<u>shell</u>	<u>115</u>	<u>320</u>			
<u>sand</u>	<u>320</u>	<u>400</u>			

IF MORE SPACE IS NEEDED, USE BACK

If well telescopes please sketch and show depths.

GROUND LEVEL

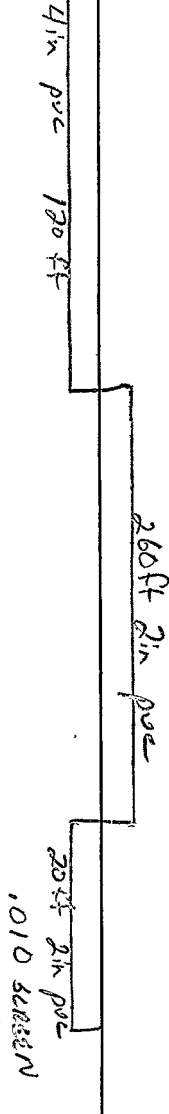

	X		

SECTION 12

Please indicate well location X.

ADDITIONAL INFORMATION

If more than one screen, show location of each on sketch.