

MISSISSIPPI DEPARTMENT OF ENVIRONMENTAL QUALITY

Office of Land and Water Resources

P. O. Box 10631
Jackson, MS 39289-0631
WATER WELL DRILLERS LOG

COUNTY WELL LOCATED Washington	
WELL NUMBER G-214	CODED
DATE WELL COMPLETED 2-7-01	

PERMIT NUMBER
NAME OF DRILLING FIRM Schudco Ltd

NAME & MAILING ADDRESS OF LANDOWNER Trey Bordelon Volland Rd Greenville Ms 38701		
WELL LOCATION: SEC	TOWNSHIP	RANGE
4	17	8
	N	E
DISTANCE	DIRECTION	NEAREST TOWN
5 Miles	South of	Greenville
OTHER LANDMARK		
WELL PURPOSE: <input checked="" type="checkbox"/> Home Irrigation, <input type="checkbox"/> Municipal, <input type="checkbox"/> Industrial, <input type="checkbox"/> Fish Pond, etc.		

PUMP DATA		
PUMP TYPE (Circle One): <input checked="" type="radio"/> Submersible Turbine, Jet Flowing Well, Other (Describe) _____		
POWER TYPE (Circle One): <input checked="" type="radio"/> Electric Tractor, Diesel, Gasoline, Butane, Other (Describe) _____ H/P 1		
Pump Capacity (GPM) 20	No. of Stages	Setting Depth 105 FT.
PUMP TEST		
Well yielded _____ GPM with a drawdown of _____ ft. after _____ hours of pumping		

WELL DATA		
Well Depth 400	Casing Diameter (In.) 4x2	Casing Length (Ft.) 380
Type of Casing pvc	Hole Depth 400	Depth to Static Water Level 42 ft
TYPE OF COMPLETION: (Circle One or More): <input checked="" type="checkbox"/> Gravel Packed, <input type="checkbox"/> Underreamed, <input type="checkbox"/> Telescoped, <input checked="" type="checkbox"/> Natural Development, <input type="checkbox"/> Open Hole, <input type="checkbox"/> Other		

LOG DATA	
TYPE OF LOG RUN (Circle One): Electric, Gamma Ray, Density, Sonic, Neutron, Other (Describe) _____ <input checked="" type="radio"/> No Log Run	
Name of Organization Running Log	

WELL GROUTED TO A DEPTH OF 10 FEET Type Grout (circle one): Cement, Bentonite, or Mix

GEOLOGIC DATA (Office Use Only)			
Surface Elev.	Geologic Unit	Unit Thickness	Depth to Top
Subs. SWL	Date	Analysis	Aquifer Test

SCREEN DATA		
Diameter - Inches 2	Length - Feet 20	Slot Size - Inches .008
Screen Type pvc	Depth to Bottom - Feet 400	


Driller's Remarks 0
Top of Lap Pipe or Reduction in Casing FEET
IF TELESCOPED OR MORE THAN ONE SCREEN: USE BACK PAGE

DESCRIPTION OF FORMATIONS ENCOUNTERED	FROM	TO
Gumbo	0	33
Sand - little p-gravel	33	115
clay	115	280
med to coarse sand	280	380
course sand	380	400

FORMATIONS (Continued)	FROM	TO
REC'D SEP 07 2001		
IF MORE SPACE IS NEEDED, USE BACK		

If well telescopes please sketch and show depths.

GROUND LEVEL

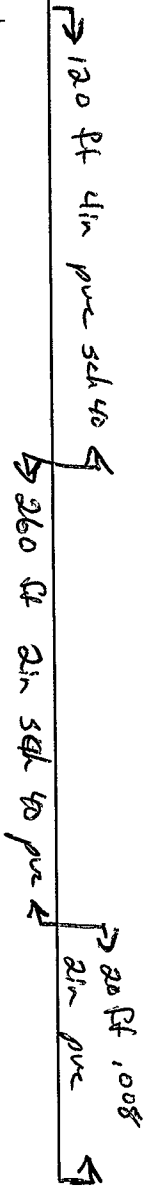

X			

SECTION 1

Please indicate well location X.

ADDITIONAL INFORMATION

If more than one screen, show location of each on sketch.