

MISSISSIPPI DEPARTMENT OF ENVIRONMENTAL QUALITY

Office of Land and Water Resources

P. O. Box 10631
Jackson, MS 39289-0631
WATER WELL DRILLERS LOG

COUNTY WELL LOCATED
Washington

WELL NUMBER G 204 CODED

DATE WELL COMPLETED
7-7-95

PERMIT NUMBER _____

NAME OF DRILLING FIRM
Schudco Ltd

NAME & MAILING ADDRESS OF LANDOWNER
Danny Homan
Wilcox Rd.
Greenville MS

WELL LOCATION: SEC _____ TOWNSHIP 12 17 RANGE S 2 E 1

DISTANCE _____ DIRECTION West NEAREST TOWN Swiftwater

OTHER LANDMARK _____

WELL PURPOSE: Irrigation, Municipal, Industrial, Fish Pond, etc.

PUMP DATA

PUMP TYPE (Circle One):
 Submersible Turbine Jet Flowing Well,
Other (Describe) _____

POWER TYPE (Circle One):
 Electric Tractor, Diesel, Gasoline, Butane,
Other (Describe) _____ H/P 1

Pump Capacity (GPM) <u>18</u>	No. of Stages <u>7</u>	Setting Depth <u>105</u> FT.
----------------------------------	---------------------------	---------------------------------

PUMP TEST

Well yielded _____ GPM with
a drawdown of _____ ft.
after _____ hours of pumping

WELL DATA

Well Depth <u>500</u>	Casing Diameter (In.) <u>4 x 2</u>	Casing Length (Ft.) <u>480</u>
Type of Casing <u>pvc</u>	Hole Depth <u>500</u>	Depth to Static Water Level <u>36 ft</u>

TYPE OF COMPLETION: (Circle One or More):
 Gravel Packed, Underreamed, Telescoped,
 Natural Development Open Hole, Other

WELL GROUTED TO A DEPTH OF 10 FEET
Type Grout (circle one): Cement Bentonite, or Mix

LOG DATA

TYPE OF LOG RUN (Circle One): No Log Run,
 Electric, Gamma Ray, Density, Sonic, Neutron,
Other (Describe) _____

Name of Organization Running Log _____

SCREEN DATA

Diameter - Inches <u>2</u>	Length - Feet <u>20</u>	Slot Size - Inches <u>.008</u>
Screen Type <u>pvc</u>	Depth to Bottom - Feet <u>500</u>	

GEOLOGIC DATA (Office Use Only)

Surface Elev.	Geologic Unit	Unit Thickness	Depth to Top
Subs. SWL	Date	Analysis	Aquifer Test

Driller's Remarks _____

DESCRIPTION OF FORMATIONS ENCOUNTERED	FROM		TO		FORMATIONS (Continued)	FROM		TO	
<u>clay</u>		<u>0</u>		<u>28</u>					
<u>sand</u>		<u>28</u>		<u>92</u>					
<u>clay & sand streaks</u>		<u>92</u>		<u>452</u>					
<u>sand</u>		<u>452</u>		<u>500</u>					

RECEIVED


JAN 16 1995

Dept. of Environmental Quality
Office of Land & Water Resources

IF MORE SPACE IS NEEDED, USE BACK

If well telescopes please sketch and show depths.

GROUND LEVEL

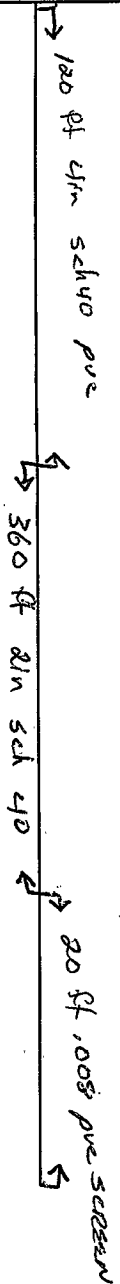

			X

SECTION 12

Please indicate well location X.

ADDITIONAL INFORMATION

If more than one screen, show location of each on sketch.