

MISSISSIPPI DEPARTMENT OF ENVIRONMENTAL QUALITY

Office of Land and Water Resources

P. O. Box 10631
Jackson, MS 39289-0631
WATER WELL DRILLERS LOG

COUNTY WELL LOCATED
Washington

WELL NUMBER 291 ✓

DATE WELL COMPLETED
9/22, 1996

PERMIT NUMBER

NAME OF DRILLING FIRM
Schudco Ltd

NAME & MAILING ADDRESS OF LANDOWNER
Agua Agri/Agua Trms

Greenwell No 387A

WELL LOCATION: SEC 30 TOWNSHIP 17 S RANGE 8 E

DISTANCE 6 Miles DIRECTION West of NEAREST TOWN Arcola

OTHER LANDMARK

WELL PURPOSE: Home, Irrigation Municipal, Industrial, Fish Pond, etc.

PUMP DATA

PUMP TYPE (Circle One): Submersible Turbine, Jet, Flowing Well, Other (Describe)

POWER TYPE (Circle One): Electric Tractor, Diesel, Gasoline, Butane, Other (Describe) H/P 20

Pump Capacity (GPM) <u>1000</u>	No. of Stages <u>1</u>	Setting Depth <u>70</u> FT.
------------------------------------	---------------------------	--------------------------------

PUMP TEST

Well yielded _____ GPM with a drawdown of _____ ft. after _____ hours of pumping

WELL DATA

Well Depth <u>88</u>	Casing Diameter (In.) <u>10</u>	Casing Length (Ft.) <u>68</u>
Type of Casing <u>pvc</u>	Hole Depth <u>90</u>	Depth to Static Water Level

LOG DATA

TYPE OF LOG RUN (Circle One): No Log Run
Electric, Gamma Ray, Density, Sonic, Neutron, Other (Describe)

Name of Organization Running Log

TYPE OF COMPLETION: (Circle One or More):
Gravel Packed Underreamed, Telescoped, Natural Development, Open Hole, Other (Describe)

WELL GROUTED TO A DEPTH OF 10 FEET
Type Grout (circle one): Cement, Bentonite, or Mix

GEOLOGIC DATA (Office Use Only)

Surface Elev.	Geologic Unit	Unit Thickness	Depth to Top
Subs. SWL	Date	Analysis	Aquifer Test

Driller's Remarks

Top of Lap Pipe or Reduction in Casing

FEET IF TELESCOPED OR MORE THAN ONE SCREEN: USE BACK PAGE

SCREEN DATA

Diameter - Inches <u>10</u>	Length - Feet <u>20</u>	Slot Size - Inches <u>1032</u>
Screen Type <u>pvc</u>	Depth to Bottom - Feet <u>88</u>	

DESCRIPTION OF FORMATIONS ENCOUNTERED	FROM	TO	FORMATIONS CONTINUED	
			FROM	TO
<u>clay</u>	<u>0</u>	<u>26</u>		
<u>sand + p-gravel</u>	<u>26</u>	<u>88</u>		
<u>clay</u>	<u>88</u>	<u>90</u>		


JAN 22 1997

Dept. of Environmental Quality
Office of Land & Water Resources

IF MORE SPACE IS NEEDED, USE BACK

If well telescopes please
sketch and show depths.

GROUND LEVEL

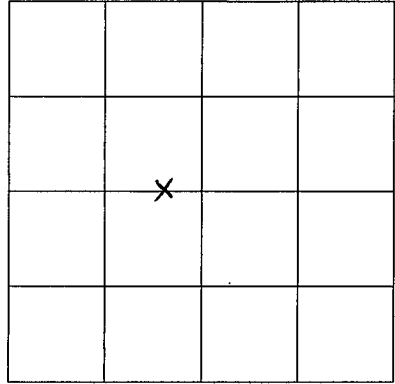

SECTION 30

Please indicate well location X.

ADDITIONAL INFORMATION

If more than one screen,
show location of each on sketch.