

MISSISSIPPI DEPARTMENT OF NATURAL RESOURCES

Bureau of Land and Water Resources

Southport Mall

P.O. Box 10631

Jackson, Mississippi 39209

WATER WELL DRILLERS LOG

CODED

WASHINGTON  
G 294

5-5-85 date well completed  
Schultz Drilling firm name  
Wash. county well located

LANDOWNER: THAD POTTER  
Hwy 438  
Greenville, MS  
(mailing address)

description of formations encountered

from to

CLAY SAND

0 20  
20 83

WELL LOCATION:  
sec. 37 T. 17 N. R. 8 E  
8 miles S of Greenville  
(distance) (direction) (nearest town)

WELL PURPOSE: IRRIGATION  
(home, irrigation, municipal, industrial)

WELL COMPLETION DATA:

(1) diameter (inches) 10"

(2) total depth (feet) 83'

(3) static water level (feet) 35' below above top of ground.

(4) casing PVC, 63'  
(material) (depth)  
(size) if telescope see back.

(5) screen 20', 63'  
(length) (depth to top)  
10", PVC  
(size) (material)

(6) pump 30 1000  
(HP) (yield gpm)  
PTO  
(type power)

(7) electric log No  
(yes or no)  
X  
(organization running log)

(8) how well bottom plugged CAP

CODED


RECEIVED

DEC 3 - 1985

DRILLERS REMARKS:

If well telescopes please sketch and show depths.

GROUND LEVEL

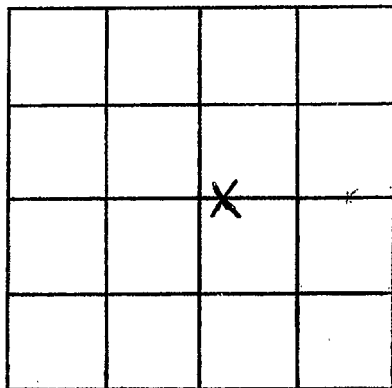

SECTION 37

Please indicate well location X.

ADDITIONAL INFORMATION

If more than one screen,  
show locations of each on sketch.