

MISSISSIPPI DEPARTMENT OF NATURAL RESOURCES

Bureau of Land and Water Resources

Southport Mall

P.O. Box 10631

Jackson, Mississippi 39209

WATER WELL DRILLERS LOG

CODED

W. H. Anderson
G 295

7-10 1985 Scholtz Drilling WASH.
 date well completed firm name county well located

LANDOWNER: MARC CURTIS
Hwy 61
Leland MS
 (mailing address)

description of formations encountered	from	to
<u>CLAY SAND</u>	<u>0</u>	<u>28</u>
	<u>28</u>	<u>90</u>

WELL LOCATION:
 sec. 36 T. 17 N R. 8 E
6 miles S of Quille
 (distance) (direction) (nearest town)

WELL PURPOSE: IRRIGATION
 (home, irrigation, municipal, industrial)

- WELL COMPLETION DATA:
- (1) diameter (inches) 10"
 - (2) total depth (feet) 90'
 - (3) static water level (feet) _____ below/above top of ground.
 - (4) casing PVC 70'
 (material) (depth)
 - _____ if telescope see back.
 (size)
 - (5) screen 20' 70
 (length) (depth to top)
 - 10" PVC
 (size) (material)
 - (6) pump 20 1000
 (HP) (yield gpm)
 - elb
 (type power)
 - (7) electric log no
 (yes or no)
 - _____ (organization running log)
 - (8) how well bottom plugged CAP


CODED

RECEIVED
 DEC 3 - 1985

DRILLERS REMARKS: _____

If well telescopes please sketch and show depths.

GROUND LEVEL

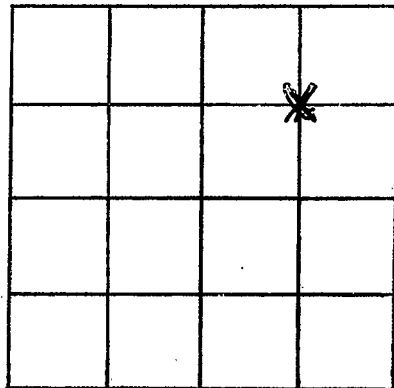

SECTION 36

Please indicate well location X.

ADDITIONAL INFORMATION

If more than one screen,
show locations of each on sketch.