

MISSISSIPPI DEPARTMENT OF NATURAL RESOURCES

Bureau of Land and Water Resources

Southport Mall

P.O. Box 10631

Jackson, Mississippi 39209

WATER WELL DRILLERS LOG

CODED

# 3  
 WASHINGTON  
 296

3-11 1985 Schultz Drilling WASH.  
 date well completed firm name county well located

LANDOWNER:  
 AQUA FARMS  
 Greenville, MS  
 (mailing address)

description of formations encountered	from	to
	CLAY SAND	0
	20	86

WELL LOCATION:  
 sec. 30 T 17 N R 8 E  
 S S of Guille  
 (distance) miles (direction) of (nearest town)

WELL PURPOSE: IRRIGATION  
 (home, irrigation, municipal, industrial)

CODED

WELL COMPLETION DATA:

(1) diameter (inches) 10"

(2) total depth (feet) 86'

(3) static water level (feet) 35' below top of ground.

(4) casing PVC, 66' (material) (depth)

(size) if telescope see back.

(5) screen 20' 66' (length) (depth to top)  
 10" PVC (size) (material)

(6) pump 20 1000 (HP) (yield gpm)  
 ele (type power)

(7) electric log NO (yes or no)  
 X (organization running log)

(8) how well bottom plugged CAP

RECEIVED


DEC 3 - 1985

DRILLERS REMARKS:

Department of Natural Resources  
 Bureau of Land & Water Resources

If well telescopes please sketch and show depths.

GROUND LEVEL

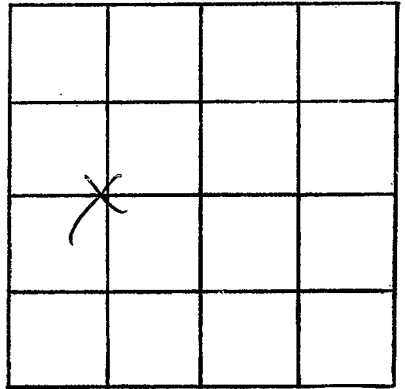

SECTION 30

Please indicate well location X.

ADDITIONAL INFORMATION

If more than one screen, show locations of each on sketch.