

**MISSISSIPPI DEPARTMENT OF ENVIRONMENTAL QUALITY**

Office of Land and Water Resources

P. O. Box 10631  
Jackson, MS 39289-0631  
**WATER WELL DRILLERS LOG**

COUNTY WELL LOCATED  
Washington

WELL NUMBER 310 CODED

DATE WELL COMPLETED  
7-8-02

PERMIT NUMBER

NAME OF DRILLING FIRM  
Schudco Ltd

NAME & MAILING ADDRESS OF LANDOWNER  
R/D Clean - Nixey Lane  
Greenville MS 38701

Latitude: 33° 18' 17" N  
Longitude: 091° 02' 25" W

WELL LOCATION: SEC 25 TOWNSHIP 17 N RANGE 8 E

DISTANCE 3 Miles DIRECTION South NEAREST TOWN Greenville

OTHER LANDMARK

WELL PURPOSE: Home, Irrigation, Municipal, Industrial, Fish Pond, etc.  
Car wash

**PUMP DATA**

PUMP TYPE (Circle One):  
Submersible Turbine, Jet, Flowing Well,  
Other (Describe)

POWER TYPE (Circle One):  
Electric Tractor, Diesel, Gasoline, Butane,  
Other (Describe) H/P 5

DESCRIPTION OF FORMATIONS ENCOUNTERED	FROM	TO
<u>clay</u>	<u>0</u>	<u>35</u>
<u>fine to med sand</u>	<u>35</u>	<u>60</u>
<u>med sand + little p-gravel</u>	<u>60</u>	<u>80</u>
<u>course sand + p-gravel</u>	<u>80</u>	<u>100</u>
<u>clay</u>	<u>100</u>	<u>150</u>
<u>sand</u>	<u>150</u>	<u>250</u>
<u>clay</u>	<u>250</u>	<u>270</u>
<u>med sand</u>	<u>270</u>	<u>360</u>
<u>med to course sand</u>	<u>360</u>	<u>380</u>

**WELL DATA**

Well Depth 380 Casing Diameter (In.) 4X3 Casing Length (Ft.) 350

Type of Casing pvc Hole Depth 380 Depth to Static Water Level 35 ft

TYPE OF COMPLETION: (Circle One or More):  
Gravel Packed, Natural Development, Underreamed, Open Hole, Telescoped, Other

WELL GROUTED TO A DEPTH OF 10 FEET  
Type Grout (circle one) Cement, Bentonite, or Mix

**SCREEN DATA**

Diameter - Inches 3 Length - Feet 30 Slot Size - Inches .008

Screen Type pvc Depth to Bottom - Feet 380

**RECEIVED**

OCT 07 2002

BY: OLWR

Top of Lap Pipe or Reduction in Casing

FEET  IF TELESCOPED OR MORE THAN ONE SCREEN: USE BACK PAGE

I certify that the well was drilled, constructed and completed in accordance with all applicable Requirements of the Mississippi Department of Environmental Quality and/or the Mississippi Department of Health regulations and state laws.


Charles M. Nichols  
Signature of Licensed Driller and License No. 0-0667

9-26-02  
Date

Additional Information Required On Back

If well telescopes please sketch and show depths.

GROUND LEVEL

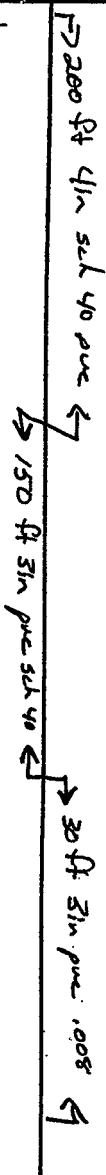

If more than one screen, show location of each on sketch.

			X

SECTION 25

Please indicate well location X.

Pump Capacity (GPM)	No. of Stages	Setting Depth
85		126 FT.

PUMP TEST

Well yielded \_\_\_\_\_ GPM with a drawdown of \_\_\_\_\_ ft. after \_\_\_\_\_ hours of pumping

LOG DATA

TYPE OF LOG RUN (Circle One): No Log Run, Electric, Gamma Ray, Density, Sonic, Neutron, Other (Describe) \_\_\_\_\_

Name of Organization Running Log

GEOLOGIC DATA (Office Use Only)

Surface Elev.	Geologic Unit	Unit Thickness	Depth to Top
Subs. SWL	Date	Analysis	Aquifer Test

Driller's Remarks

\_\_\_\_\_

\_\_\_\_\_

