

State Well Report

Part 1

Mississippi Department of Environmental Quality
 Office of Land and Water Resources
 P.O. Box 10631
 Jackson, MS 39289-0631
 (601)961-5210
 (601)354-6938 (fax)

For Office Use Only:

Aquifer: _____
 Well #: G-331
 L. S. Elevation: _____
 E-log #: _____

County: Washington
 Permit #: OW41997
 Driller: JAMES HAGGER
 Date drilling completed: 5-21-07

State Law requires that this report be prepared by the driller in detail and filed with the Department within 30 days of completion of drilling of the well.

Well Owner Information	Well Location
Owner Name: <u>Gaylon Lawrence</u>	Latitude: <u>33° 17' 54"</u> Longitude: <u>91° 27⁰⁷ 47"</u>
Mailing Address: <u>DELTA PINE LAND MGT.</u> <u>Po Box 5669</u> <u>GREENVILLE, MS 38704</u> City State Zip Code	Method of Lat/Long (circle one): Conventional Survey, <u>DLUSGS</u> quad, Hand-held GPS, Survey-grade GPS <u>SW 1/4 SE 1/4</u> Sec <u>607</u> Twn <u>17N</u> Rng <u>9W</u>
Telephone No: <u>(663) 349-8669</u>	Distance <u>8</u> Miles Direction <u>SW</u> of Nearest Town <u>GREENVILLE</u>

Well Data

Purpose of Well (circle one) Home Industrial Public Supply Irrigation Fish Culture Other: _____

Date well drilling started: 5-21-07 Date well drilling completed: 5-21-07

If flowing, method of flow regulation: Valve _____ Other (describe) _____

Static Water Level: 17 feet above or below (circle one) land surface Date measured: _____

Method of Measurement (circle one) steel tape electric tape air line other: _____

Hole depth: 118 Well depth: 114 Well grouted to a depth of 10 feet

Type of grout (circle one): Cement Bentonite Mix

Casing length: 74 feet Casing diameter: 16 inches Type of casing: PVC

Screen length: 40 feet Screen diameter: 16 inches Type of screen: PVC

Screen slot size: .050 inches Setting depth: From 74 feet to 114 feet

Type of completion (circle all applicable): Gravel packed Underreamed Telescoped Open hole Natural Development
 Other (describe): _____

Top of lap pipe or reduction in casing: _____ feet. If telescoped or more than one screen, describe on back of page

Logs run (circle all applicable): No log run Electric Gamma Ray Density Sonic Neutron Other: _____

Name of organization running log(s): _____

I certify that the well was drilled, constructed, and completed in accordance with all applicable requirements of the Mississippi Department of Environmental Quality and/or the Mississippi Department of Health regulations and state laws.

X HAGGER Well Service (#542)
 Print Name of Water Well Contractor and License No.


X James Hagger
 Signature of Water Well Contractor

RECEIVED
 JUL 16 2007
 BY: OLWR

G-

If well telescopes please sketch below and show depths.

Ground Level

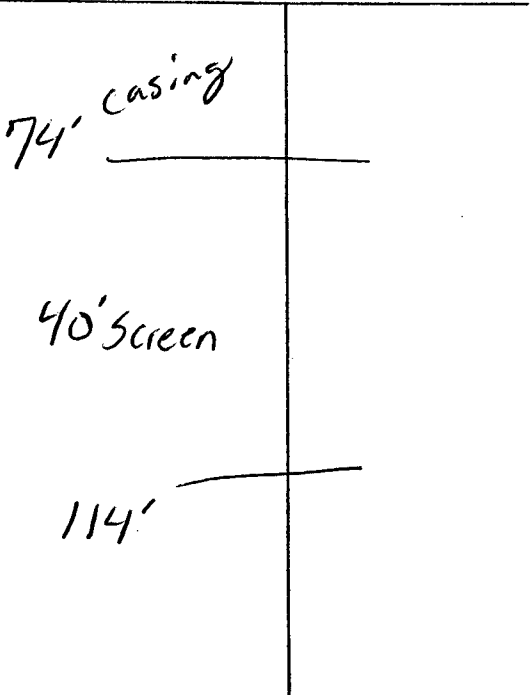


Description of Formations Encountered

From To

Description of Formations Encountered	From	To
Clay	0	66
Fine	66	80
med coarse mix	80	118

If more than one screen, show location of each on sketch

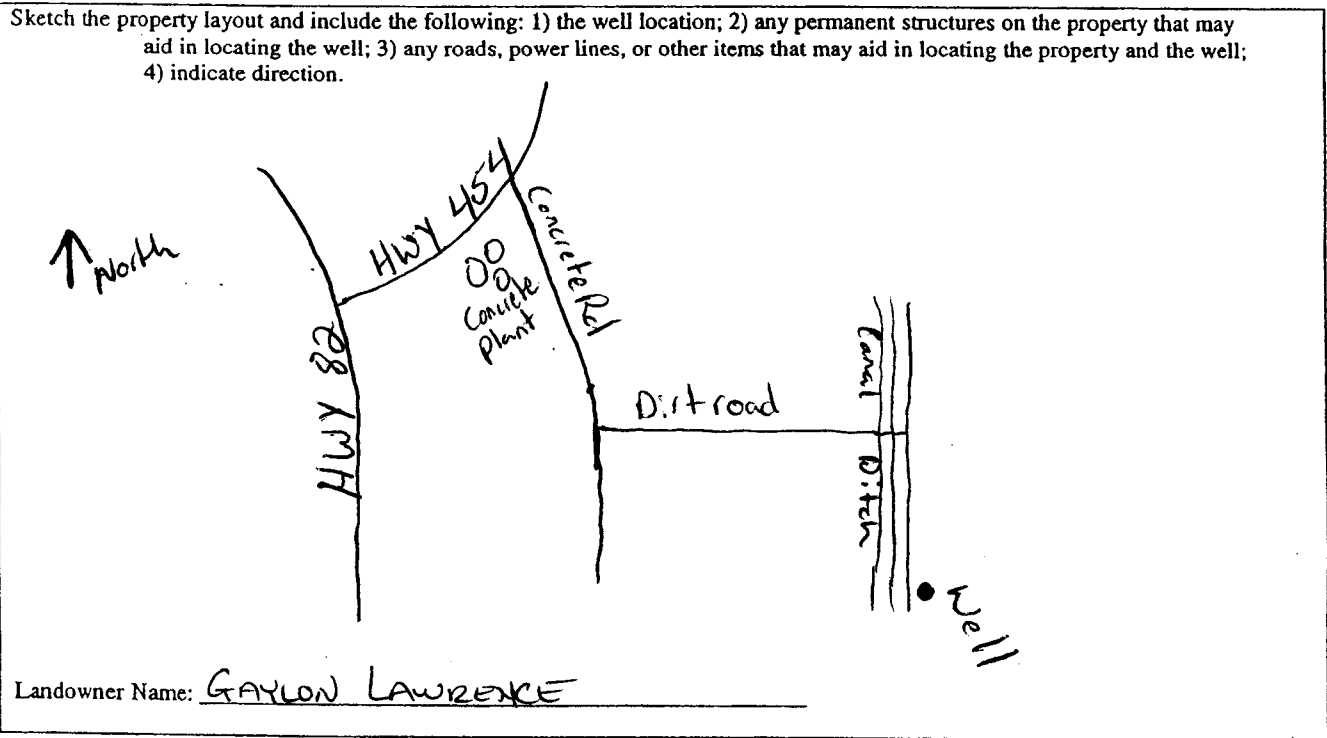

James Hagan
 Signature of Water Well Contractor

STATE WELL REPORT

Part 2

Pump Installer's Completion Report
 Mississippi Department of Environmental Quality
 Office of Land and Water Resources
 P.O. Box 10631
 Jackson, MS 39289-0631
 (601)961-5210
 (601)354-6938 (fax)

For Office Use Only:

Aquifer: _____

Well #: G-331

Elevation: _____

County: WASHINGTON
 Permit #: GW41997
 Driller: JAMES HASSER
 Date completed: 5-21-07

This report should be prepared by the pump installer in detail and filed with the Department within 30 days of the installation of pump.

Well Owner Information	Well Location
Owner Name: <u>CAYLON LAWRENCE</u>	Latitude: <u>33-17-54</u> Longitude: <u>91-27-47</u> ⁰⁷
Mailing Address: <u>DELTA PINE LAND MS</u>	Method of Lat/Long (circle one): Conventional Survey,
<u>PO Box 5669</u>	USGS quad, Hand-held GPS, Survey-grade GPS
<u>GREENVILLE, MS 38704</u>	SW <u>SE</u> 1/4 Sec <u>6</u> Twn <u>17N</u> Rng <u>9W</u>
City: _____ State: _____ Zip Code: _____	<u>IR</u> <u>IR</u> <u>07</u>
Telephone No: <u>663-349-8669</u>	Distance: _____ Direction: _____ Nearest Town: _____
	<u>8</u> Miles <u>SW</u> of <u>GREENVILLE</u>

Pump Type Circle one	Power Type Circle one
Air Lift Jet Submersible	<u>Diesel Engine</u> Gasoline Engine Natural Gas
Bucket Piston <u>Turbine</u>	Electric Motor Hand Tractor PTO
Centrifugal Rotary Flowing Well	Windmill Other (specify): _____
Other (specify): _____	Horse Power Rating of Motor: <u>600</u>
Date Pump Installed: <u>6-19-07</u>	Setting Depth: <u>600</u> feet
Rated Pump Capacity: <u>2000</u> Gallons Per Minute	Number of Stages: <u>1</u>

Pump Test Data	Method of Measuring Water Level Circle one
Date Well Tested: _____	Air Line Electric Measuring Line Steel Tape
Static Water Level (A): <u>No Test</u> Feet Below Land Surface	Other (specify): _____
Pumping Water Level (B): _____ Feet Below Land Surface	For flowing well, measured shut in head: _____ feet
Drawdown [(B) - (A)]: _____ Feet Below Land Surface	Well yielded _____ GPM with a drawdown of _____ feet after _____ hours of pumping
Test Pumping Rate: _____ Gallons Per Minute	
Duration of Pump Test (minimum 4 hours): _____ hours	

I HEREBY CERTIFY that the above statements are true to the best of my knowledge.

Print Name of Pump Installer and License No. (if applicable) _____ Signature of Pump Installer _____

RECEIVED
 JUL 16 2007
 BY: OLWR