

G-332

WASHINGTON

~~006~~ 332

11/178

MISSISSIPPI
BOARD OF WATER COMMISSIONERS
416 North State Street
Jackson, Mississippi 39201

CODED

WATER WELL DRILLERS LOG

11- date well completed 1978 Lipe Well Co. firm name Washington county well located

LANDOWNER: COMET DELTA
Pacific Rice Int.
Greenville M.S.
(mailing address)

description of fomations encountered	from	to
Sand	0	20
Clay	20	40
Sand and clay	40	60
Pea gravel	60	80
Sand	80	120
Sand and clay	120	200
Sand	200	280
Cl	280	320
	320	446

WELL LOCATION:
sec. 16 T. 18 N. R. 9 E. S. W.
3 miles West of Greenville
(distance) (direction) (nearest town)

WELL PURPOSE:
~~(Irrigation)~~ Irrigation, municipal, Industrial

- WELL COMPLETION DATA:
- (1) diameter (inches) 6
 - (2) total depth (feet) 446
 - (3) static water level (feet) 73 below above top of ground.
 - (4) casing Steel 396
(material) (depth)
6 if telescope see back.
(size)
 - (5) screen 30 384
(length) (depth to top)
4 S. Steel
(size) (material)
 - (6) pump 20 150
(HP) (yield gpm)
elec.
(type power)
 - (7) electric log no
(yes or no)
no
(organization running log)
 - (8) how well bottom plugged S&V
plug

CODED


RECEIVED
DEC - 4 1978

MISS. BD. OF WATER COMM

DRILLERS REMARKS:

If well telescopes please sketch and show depths.

GROUND LEVEL

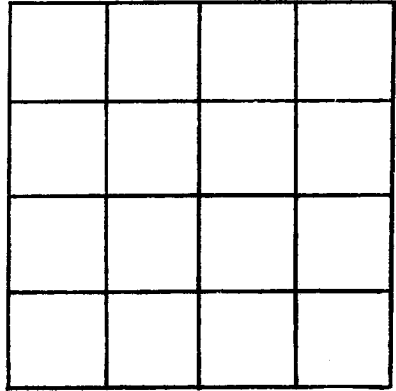

SECTION _____

Please indicate well location X.

ADDITIONAL INFORMATION

If more than one screen, show locations of each on sketch.