GATIAND LAW RENCE . PRISON

.

**		
	ATE WELL REPORT	
County: MASHINGTON	Part 1	For Office Use Only:
Permit #: (1)-475/6 Mississipp	Driller's Log i Department of Environmental Quality	Well #: <u>6364</u>
Driller: J.NEWCOME 0.773 Off	ice of Land and Water Resources	Aquifer:
Date drilling completed: $3 \cdot 11 \cdot 14$	P.O. Box 2309 Jackson, MS 39225-2309	E-Log #:
	(601)961-5210 (601)360-0535 (fax)	
State Law requires that this report be prepare Department at the above address within 30 da	d by the license holder responsible for t	he work and filed with the
Well Owner Information	Well or Bore	hole Location
(Landowner if borehole is not for a water we Owner Name: Delta Pinchand Company	(1) 23 19 58 "	gitude: 091'07`58"
Mailing Address: P.O. Box 5669	Method of Lat/Long (check one)	: Conventional Survey,
	USGS quad, Hand-held G	PS, Survey-grade GPS
Greenville MS 387 City State Zip		03 TITN ROGW
City State Zip	CodeMiles _S.W. of	
Telephone No. ()		(Nearest Town)
	Vell / Borehole Data	
Date drilling started: $3 \cdot 11 \cdot 14$ Date drilling corr Location of the source of any surface water used for Method of dosing and volume of Chlorine used in d	or drilling: <u>DITcH</u>	
	Gamma Ray Density Sonic Neutror	
Name of organization running log(s):		
Purpose of borehole (circle one) Water Well Ge	otechnical/Geological Investigation G	round Source Heat Pump
Seismic Survey	Other (describe)	
If drilling is not related to water	well construction, skip the remainder of	of this block
Purpose of Well (circle all applicable): Home Ind	ustrial Public Supply Irrigation Fi	sh Culture
Other (describe):		
If a flowing well, method of flow regulation: Valve	Other (describe)	
Static Water Level:feet [above or (circle o	below] land surface Date measured: ne)	
Method of measurement (circle one): Steel tape El	ectric tape Air line Other (describe): _	
Well depth: $\underline{120}$ Well grouted to a depth of: $\underline{1}$	D feet Type of grout (circle one): N	leat Cement Bantonith
	11	sing: <u>P.N.C.</u>
		reen: P.V.C.
	depth: From <u>80</u> feet to _	120 feet
Type of completion (circle all applicable): Gravel pa	cked Underreamed Open hole	Natural Development
Other (describe):	· · · · · · · · · · · · · · · · · · ·	
Top of lap pipe or reduction in casing:	-	
i lelescopeu or more	than one screen, describe on next page	

Form: OLWR-SWR-1A (4/13)


County:	
Permit #:	

For	Office	Use	Only:
-----	--------	-----	-------

Well #: _

The sketch below only required for water wells

If well telescopes, show depths on sketch.

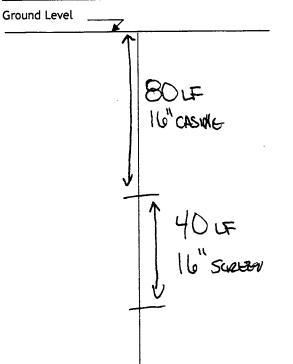

Description of formations encountered must be provided for all wells			
and boreholes, unless specifically exempted by regulations			

Description of Formations Encountered	From (depth)	To (depth)
TOP SOIL	Ground level	10
UPT	10	40
CLAY FING SAND MUL	40	50
FAIR FWESAND	SD	80
MEDIUM SAND	80	90
COADSE SAND	90	100
PEBBLES WASE SAND	100	F20
BOTTOM	no	22
	•	
······································		
	<u> </u>	

If more than one screen, show location of each on sketch

Sketch the property layout and include the following:

1) the well location

2) any permanent structures on the property that may aid in locating the well3) any roads, power lines, or other items that may aid in locating the property and the well

4) north arrow

SEE	MAP

Landowner	N	lame:	
-----------	---	-------	--

I HEREBY CERTIFY that the well/borehole was drilled, constructed, and completed in accordance with all applicable requirements of the Mississippi Department of Environmental Quality and the Mississippi Department of Health regulations, if applicable, and state laws.

JOHN NEWCOME 0.773	3.11.2014	ad Aleucine
Print Name of Responsible Licensee and License No.	Date	Signature of Licensee
Fille Name of Responsible Electisee and Election		Form: OLWR-SWR-1A (4/13)

	STATE W	ELL REPORT		
County: Washington		Part 2	For Office Use Only:	
Permit #: 6W-49516		er's Completion Report nent of Environmental Quality	Well #: <u>6364</u>	
Driller: J. Neucome 0-773	Office of La	nd and Water Resources	weit #. <u>C. 29 1</u>	
Date completed: <u>3-11-14</u>		.O. Box 2309 on, MS 39225-2309	Aquifer:	
<u>Copy information from block on Part 1</u>	· ((601)961-5210		
) 360-0535 (fax)		
This part of the report must be complete of the report must be attached and both	parts filed with the L	well contractor or a licensed pun Department at the above address w	np installer. A copy of Part 1 ithin 30 days of well completion.	
Well Owner Informati		Well Lo		
Owner Name: Delte Pine Land	Company LP	Latitude: 33. 19.58 Long	gitude: <u>91.07.58</u>	
Mailing Address: <u>P.O. Bax</u> 566	9	Method of Lat/Long (check one)	: Conventional Survey,	
		USGS quad, Hand-held GP	S_X , Survey-grade GPS	
City State	387041	<u>SE 14 NW 14, Sec (</u>	03 T/7N R 09 J	
			Greenw, //e (Nearest Town)	
Telephone No. ()		(Distance) (Direction)	(Nearest Town)	
		pe (circle one)	<u></u>	
Submersible Turbine Air Lift Centrifu	ugal Flowing Well	Jet Piston Rotary Other (des	cribe):	
Date Pump Installed: 3-13-14				
Is This Pump (circle one): New Rep				
	Power Ty	pe (circle one)		
Electric Diesel Gasoline Natural Gas	Tractor PTO Win	dmill Other (<i>describe</i>):		
Horse Power Rating of Motor: _50 ⁴	<u>P</u> Setting Dept	h: <u>70</u> feet Number	of Stages:	
	Pump Test Data	for Non Flowing Well		
Date Well Tested:	sted	Duration of Pump Test (minimu	Im 4 hours): hours	
Static Water Level (A): C+ Feet	Below Land Surface	Pumping Water Level (B):	Feet Below Land Surface	
	Feet Below Land Surf			
Method of measurement (circle one): Ste				
		a for Flowing Well		
Measured shut in head:feet.	Nat	Lor Lo		
Well yieldedGPM with a d	rawdown of	ested	nours of pumping	
Meter Installation				
Meter Model Number/Name: Type of Meter:				
Totalizer Register Unit and Multiplier Factor (AF x .001, gal x 1000, etc):				
Installation Date: Meter installed by:				
Is This Meter (circle one): New Repaired Replacement				
Important: By submitting the above inf For agricultur	ormation you are ce al wells, a list of app	rtifying that this meter was install roved meters is on the MDEQ we	ed to manufacturer standards. bsite.	
I HEREBY CERTIFY that the above statem	ients are true to the	e best of my knowledge.		
Hubbard Stephens a	2741-P	4/1/14 Abill	le l	
Print Name of Pump Installer and Licens	e No. (<i>If applicable</i>)	Date Signatu	ire of Pump Installer	
		•	Form: OLWR-SWR-1B (4/13	

4

.