

G 88 1088  
3-27-64

WATER WELL DRILLERS LOG

CODED

Date: 3/27, 1964, Driller: Bailey Drilg. Co. County Washington  
(Name)

(1) Owner of Land:	Description & Color of Materials Sand, Clay, Red Clay, Shell, etc.	Thick- ness Feet	Depth Feet
Elisha Johnson (Name) Hwy 82 W., Greenville, Miss (Address)	Clay		40
	Sand		70
(2) Location: 1/4, 1/4, Sec. 3 T. R.	Gravel		100
6 miles S.W. of Greenville, (distance) (direction) (Nearest Town)	Mud		325
(3) Topography: Flat (Hilly) (Flat) (Level)	Sand		360
(4) Purpose of Well: Domestic (Domestic Irrigation Municipal, Industrial, Other)			

Information upon completion of well:

(1) Diameter 2 inches.

(2) Total Depth 360 feet.

(3) Water Level 37 feet below top of ground.

(4) Cased to All way, Size 2"

(5) Screen: Size 2" Length 10 ft.

(6) Were any formations sealed against pollution?  
yes, X no.


Insuff. info.  
to locate

CODED

If YES depth of formation \_\_\_\_\_

Why \_\_\_\_\_

Drillers Remarks: \_\_\_\_\_

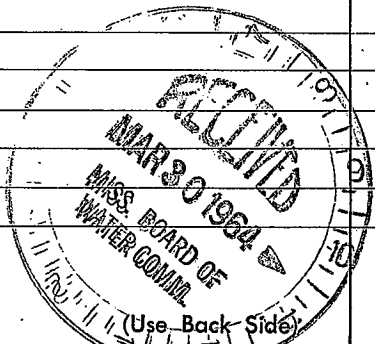

Well No.

