

WASHINGTON  
 G 2000  
 12-2-75

MISSISSIPPI  
 BOARD OF WATER COMMISSIONERS  
 416 North State Street  
 Jackson, Mississippi 39201

WATER WELL DRILLERS LOG

2 Dec 1975 date well completed  
 157 Lambert Dr. firm name  
 Wash county well located


LANDOWNER:	description of formations encountered	from	to
J. F. Grice	Clay	0	30
Arcola, Miss. (mailing address)	Sand	30	94
WELL LOCATION: sec 30 T 17 N R 8 E W 10 miles S/E of Greenville (distance) (direction) (nearest town)	blue shell	94	120
WELL PURPOSE: name (home, irrigation, municipal, industrial)	Sand & Clay st	120	320
WELL COMPLETION DATA:	Sand st. clay	320	360
(1) diameter (inches) 2	Sand, tight	360	400
(2) total depth (feet) 440	Sand, grade	400	450
(3) static water level (feet) 42 below top of ground.			
(4) casing PVC, 430 (material) (depth) 2 (size) if telescope see back.			
(5) screen 10, 430-440 (length) (depth to top) 2 PVC (size) (material)			
(6) pump 1, 10 (HP) (yield gpm) elect (type power)			
(7) electric log (yes or no)			
(organization running log)			
(8) how well bottom plugged: Back wash			
DRILLERS REMARKS:			

RECEIVED  
 MISSISSIPPI  
 JAN 13 1976

MISS. Bd. OF WATER COMMISSIONERS

If well telescopes please sketch and show depths.

GROUND LEVEL

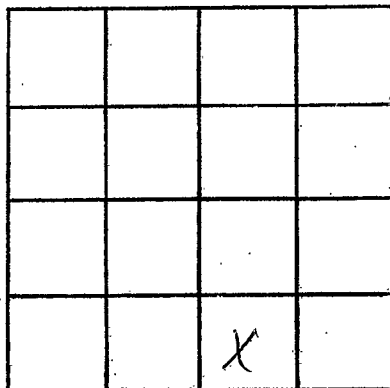

SECTION 30

Please indicate well location X.

ADDITIONAL INFORMATION

If more than one screen,  
show locations of each on sketch.