

WASHINGTON
 G 2001
 12-8-75

MISSISSIPPI
 BOARD OF WATER COMMISSIONERS
 416 North State Street
 Jackson, Mississippi 39201

WATER WELL DRILLERS LOG

8 Dec 1975 date well completed
 Lambert Drilling Co. firm name
 Wash. county well located


LANDOWNER:	description of formations encountered	from	to
(mailing address)			
Geo. Burnside Greenville, Miss.	Clay	0	70
WELL LOCATION: sec 24 T17 N. R 8 E 9 miles S of Greenville (distance) (direction) (nearest town)	Sand - light	70	50
WELL PURPOSE: none (home, irrigation, municipal, industrial)	Sand	50	94
WELL COMPLETION DATA: (1) diameter (inches) 2 (2) total depth (feet) 420 (3) static water level (feet) 32 below top of ground. (4) casing PVC 410 (material) (depth) 2 (size) if telescope see back. (5) screen 10 410-420 (length) (depth to top) 2 PVC (size) (material) (6) pump 1 10 (HP) (yield gpm) elect (type power) (7) electric log (yes or no) (organization running log) (8) how well bottom plugged back wash.	bl. Shell	94	135
	Clay	135	180
	Clay st. sand	180	260
	Sand - light	260	360
	Sand	360	390
	Sand - good	390	445
DRILLERS REMARKS:			

REGISTERED
 IAN 13 1976

MISS. BD. OF WATER COMMISSIONERS

If well telescopes please sketch and show depths.

GROUND LEVEL

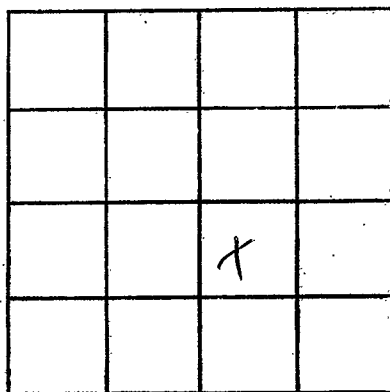

SECTION 24

Please indicate well location X.

ADDITIONAL INFORMATION

If more than one screen,
show locations of each on sketch.