

WASHINGTON

G 2002

12-20-75

MISSISSIPPI
BOARD OF WATER COMMISSIONERS
416 North State Street
Jackson, Mississippi 39201

WATER WELL DRILLERS LOG

20 Dec 1975 Lambert Drilling Co Wash. date well completed firm name county well located

LANDOWNER:	description of formations encountered	from	to
BASF Wyandotte Research Farm Greenville (mailing address)	Mixed	0	15
WELL LOCATION: sec 4 T 17 N R 9 E 7 miles S/W of Greenville (distance) (direction) (nearest town)	Sand	15	60
WELL PURPOSE: Ind. (home, irrigation, municipal, industrial)	Sand & grav.	60	110
WELL COMPLETION DATA:	Clay	110	175
(1) diameter (inches) 4 X 2 1/2	Sand & clay	175	185
(2) total depth (feet) 410	Rock	185	186
(3) static water level (feet) 42 below top of ground	Sand & clay	186	210
(4) casing Galv. 380 (material) (depth)	Sand fine	210	270
4 X 2 1/2 if telescope see back (size)	Sand med.	270	300
(5) screen 30' 480-410 (length) (depth to top)	Sand good	340	420
2 1/2 8.5 (size) (material)			
(6) pump 5 50 (HP) (yield gpm)			
elect (type power)			
(7) electric log (yes or no)			
(organization running log)			
(8) how well bottom plugged back wash			
DRILLERS REMARKS:			

JAN 13 1976

MISS. BD. OF WATER COMMISSIONERS

If well telescopes please sketch and show depths.

GROUND LEVEL

147

4¹⁰

147

1


380

2 1/2

380

410

2 1/2 SS
50'

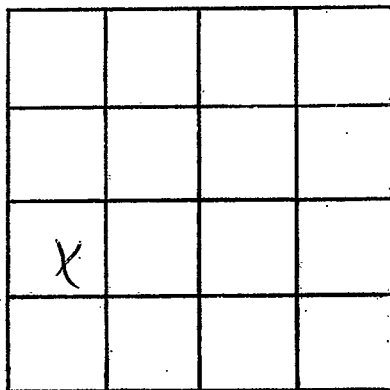

SECTION 7

Please indicate well location X.

ADDITIONAL INFORMATION

If more than one screen,
show locations of each on sketch.