

Washington  
 G 2004  
 7/26/76

MISSISSIPPI  
 BOARD OF WATER COMMISSIONERS  
 416 North State Street  
 Jackson, Mississippi 39201

151

WATER WELL DRILLERS LOG

July 26 1976 Schultz Drilling Washington  
 date well completed firm name county well located

LANDOWNER: Farm Supply  
Rt. 2  
GREENVILLE Miss  
 (mailing address)

description of formations encountered	from to	
Clay	0	26
Sand + gravel	26	93
Clay	93	140
Sand	140	149
Clay	149	193
sandy shale	193	240
Clay	240	360
Sand	360	400

WELL LOCATION:  
 sec 28 T 17 N R 8 E  
5 miles 3 of Greenville  
 (distance) (direction) (nearest town)

WELL PURPOSE: shop  
 (home, irrigation, municipal, industrial)

- WELL COMPLETION DATA:
- (1) diameter (inches) 2"
  - (2) total depth (feet) 380
  - (3) static water level (feet) 24 below top of ground
  - (4) casing PVC (material) (depth)
  - 2 (size) If telescope see back.
  - (5) screen 10 (length) (depth to top)
  - 2" (size) PVC (material)
  - (6) pump 1 (HP) 10 (yield gpm)
  - (type power)
  - (7) electric log No (yes or no)
  - (organization running log)
  - (8) how well bottom plugged spwash


DRILLERS REMARKS:

RECEIVED  
 AUG 24 1976

MISS. BD. OF WATER COMM

If well telescopes please sketch and show depths.

GROUND LEVEL

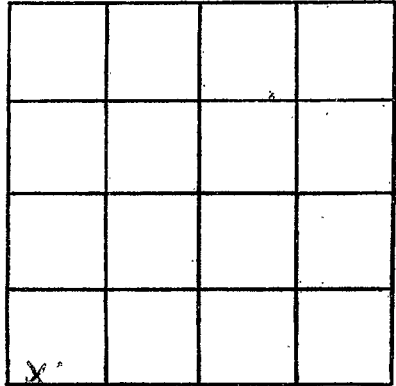

SECTION 28

Please indicate well location X.

ADDITIONAL INFORMATION

If more than one screen,  
show locations of each on sketch.