

Washington
 G
 8/26/76

MISSISSIPPI
 BOARD OF WATER COMMISSIONERS
 416 North State Street
 Jackson, Mississippi 39201

WATER WELL DRILLERS LOG

26 Aug 1976 date well completed
 Lambert Drilling Wash firm name
 Wash county well located

LANDOWNER:	description of formations encountered	from	to
Paul Evans Greenville, Miss. (mailing address)	0-45 Cl Clay	0	45
WELL LOCATION: sec 25 T 17 N R 8 E S W 6 miles S of Greenville (distance) (direction) (nearest town)	Sand	45	60
WELL PURPOSE: home (home, irrigation, municipal, industrial)	Sand & fine gravel	60	92
WELL COMPLETION DATA: (1) diameter (inches) 4 X 2 (2) total depth (feet) 480 ft (3) static water level (feet) 52 below top of ground. (4) casing PVC 460 (material) (depth) 4 X 2 if telescope see back. (size) (5) screen 20 480-460 (length) (depth to top) 2" PVC (size) (material) (6) pump 1 20 (HP) (yield gpm) elect (type power) (7) electric log (yes or no) (organization running log) (8) how well bottom plugged back wash	Clay Shell	92	145
	Clay st. Sand.	145	210
	Clay st. Sand.	210	365
	Sand, tight	365	405
	Sand, 1/2 in. st	405	450
	Sand, good.	450	490
DRILLERS REMARKS:			

RECEIVED
 OCT 2 1976

MISS. Bd. OF WATER COMMISSIONERS


If well telescopes please sketch and show depths.

GROUND LEVEL

140 4' 10"

320 2' 11"

20 WS,
480

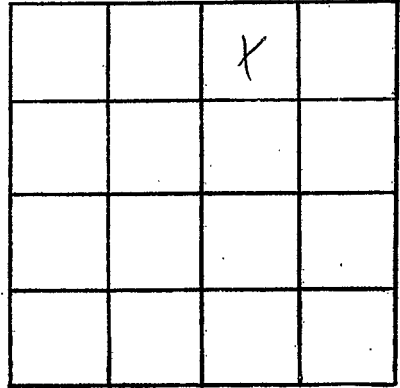

SECTION 25

Please indicate well location X.

ADDITIONAL INFORMATION

If more than one screen,
show locations of each on sketch.