

Washington  
G 2007  
10-7-76

MISSISSIPPI  
BOARD OF WATER COMMISSIONERS  
416 North State Street  
151 Jackson, Mississippi 39201

WATER WELL DRILLERS LOG

10-7  
date well completed

1976 Bailey Drilling Co  
firm name

Washington  
county well located

LANDOWNER: John Kirk  
Greenville, Miss.

description of formations encountered

from to

Clay 0 12  
Sand 12 68

(mailing address)

WELL LOCATION:

sec. 19 T 17 N R 9 E  
5 miles SW of Greenville  
(distance) (direction) (nearest town)

WELL PURPOSE: Farm  
(home, irrigation, municipal, industrial)

WELL COMPLETION DATA:

- (1) diameter (inches) 2  
(2) total depth (feet) 68  
(3) static water level (feet) 22 below above top of ground.  
(4) casing steel, 63, (material) (depth)  
2" If telescope see back. (size)  
(5) screen 5 ft, 63 (length) (depth to top)  
2" Stainless steel (size) (material)  
(6) pump 1/2 6 (HP) (yield gpm)  
elec (type power)  
(7) electric log No (yes or no)

(organization running log)

(8) how well bottom plugged  
Back pressure valve


DRILLERS REMARKS:

RECEIVED  
OCT 12 1976

MISS. Bd. OF WATER COMMISSIONERS

If well telescopes please sketch and show depths.

GROUND LEVEL

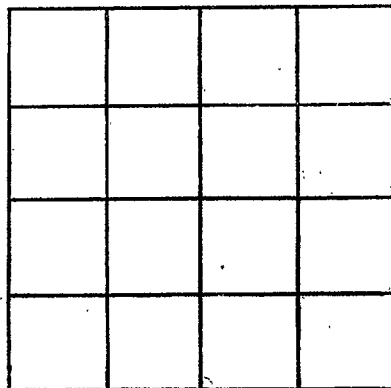

SECTION \_\_\_\_\_

Please indicate well location X.

ADDITIONAL INFORMATION

If more than one screen,  
show locations of each on sketch.