

WASHINGTON  
G 2008  
12/1/76

MISSISSIPPI  
BOARD OF WATER COMMISSIONERS  
416 North State Street  
Jackson, Mississippi 39201

WATER WELL DRILLERS LOG

1 Dec 1976 Lambert Drilling Wash  
date well completed firm name county well located

LANDOWNER:	description of formations encountered	from	to
(mailing address)			
A. D. Bullard Greenville, Miss.	Mixed	0	15
	Clay	15	38
	Sand	38	50
	Sand & gravel	80	115
	Clay shell	115	150
	Clay st. sand	150	285
	Sand	285	390

LANDOWNER:  
A. D. Bullard  
Greenville, Miss.  
(mailing address)

WELL LOCATION:  
sec. 13 T 17 N R 9 E  
8 miles S of Greenville  
(distance) (direction) (nearest town)

WELL PURPOSE: home  
(home, irrigation, municipal, industrial)


- WELL COMPLETION DATA:
- (1) diameter (inches) 2
  - (2) total depth (feet) 380
  - (3) static water level (feet) 40 below top of ground.
  - (4) casing PVC 270  
(material) (depth)
  - 0 (size) if telescope see back.
  - (5) screen 10 280  
(length) (depth to top)
  - 2 PVC  
(size) (material)
  - (6) pump 1 10  
(HP) (yield gpm)
  - elect  
(type power)
  - (7) electric log (yes or no)
  - (organization running log)
  - (8) how well bottom plugged  
backwash

DRILLERS REMARKS:

RECEIVED  
JAN 10 1977  
MISS. BD. OF WATER COMM.

If well telescopes please sketch and show depths.

GROUND LEVEL

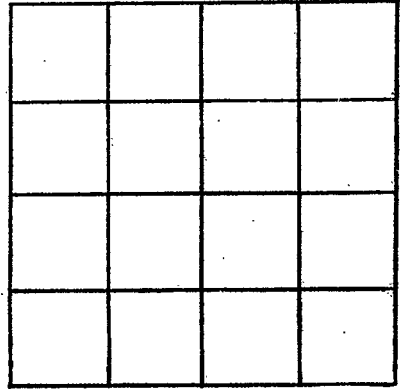

SECTION \_\_\_\_\_

Please indicate well location X.

ADDITIONAL INFORMATION

If more than one screen,  
show locations of each on sketch.