

WASHINGTON

G 2011

2-5-77

MISSISSIPPI BOARD OF WATER COMMISSIONERS
416 North State Street
151 Jackson, Mississippi 39201

WATER WELL DRILLERS LOG

5 Feb.

date well completed

1977 Lambert Drilling

firm name

Wash

county well located

LANDOWNER:	description of formations encountered	from	to
Billy Barton Greenville (mailing address)			
WELL LOCATION: sec 23 T 17 N R 9 E S W 4.4 miles S of Greenville (distance) (direction) (nearest town)	Sand. fine	30	60
WELL PURPOSE: none (home, irrigation, municipal, industrial)	Sand.	60	90
WELL COMPLETION DATA: (1) diameter (inches) 4X2 (2) total depth (feet) 465 (3) static water level (feet) 48 below top of ground. (4) casing PVC 445 (material) (depth) 4X2 (size) if telescope see back. (5) screen 20 405-445 (length) (depth to top) 2" PVC (size) (material) (6) pump 1 20 (HP) (yield gpm) Elect (type power) (7) electric log (yes or no) (organization running log) (8) how well bottom plugged back wash	gravel	90	125
	Clay blue	125	160
	Clay	160	205
	Clay st. sand	205	310
	Sand & clay sh	310	405
	Sand. fine	405	435
	Sand. good	435	475
DRILLERS REMARKS:			

RECEIVED
MAR - 7 77

MISS. BO. OF WATER COMMISSIONERS


If well telescopes please sketch and show depths.

GROUND LEVEL

140 4''

495 2''

465 2'' School

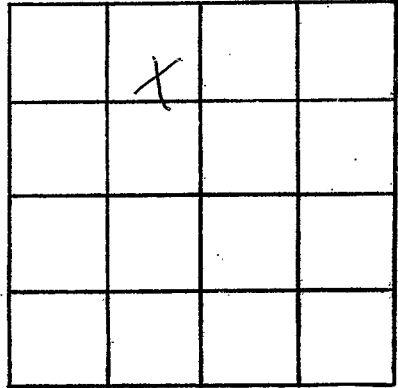

SECTION 23

Please indicate well location X.

ADDITIONAL INFORMATION

If more than one screen,
show locations of each on sketch.