




If well telescopes please sketch and show depths.

GROUND LEVEL

~~140~~ 4''

~~355~~ 2''

~~375~~ 2'' 50' well

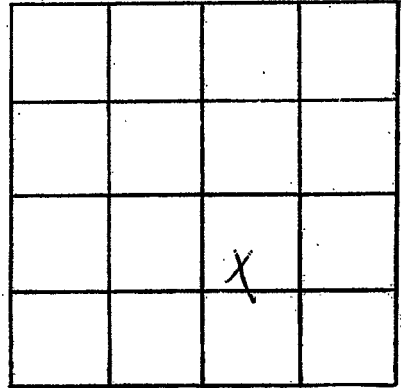

SECTION 13

Please indicate well location X.

ADDITIONAL INFORMATION

If more than one screen, show locations of each on sketch.