

WASHINGTON

G 2015

5-6-77

MISSISSIPPI
BOARD OF WATER COMMISSIONERS
416 North State Street
Jackson, Mississippi 39201

151

WATER WELL DRILLERS LOG

6 May

date well completed

1977

Lambert Drilling & Center Wash
Harvey Green

firm name

county well located

LANDOWNER:	description of formations encountered	from	to
Harvey Green Greenville, Miss. (mailing address)	Mixed Clay	0 15	15 30
WELL LOCATION: sec. 8 T. 17 N. R. 8 E. W. 8 16 2 1/2 miles SE of Greenville (distance) (direction) (nearest town)	Sand Sand & fine gravel blue shell Clay Sand fine Sand, Ft. Clay Sand, good	30 75 75 102 102 165 165 195 250 405	75 102 165 195 250 405 480
WELL PURPOSE: none (home, irrigation, municipal, industrial)			
WELL COMPLETION DATA: (1) diameter (inches) 4x2 (2) total depth (feet) 480 (3) static water level (feet) 42 below top of ground. (4) casing PVC 460 (material) (depth) 4x2 (size) if telescope see back. (5) screen 20, 480-460 (length) (depth to top) 2" PVC (size) (material) (6) pump 1 (HP) 20 (yield gpm) elect (type power) (7) electric log (yes or no) (organization running log) (8) how well bottom plugged backwash			
DRILLERS REMARKS:			

RECEIVED
JUN 29 1977

MISS. BD. OF WATER

If well telescopes please sketch and show depths.

GROUND LEVEL

411


140

211

460

2" screen

480

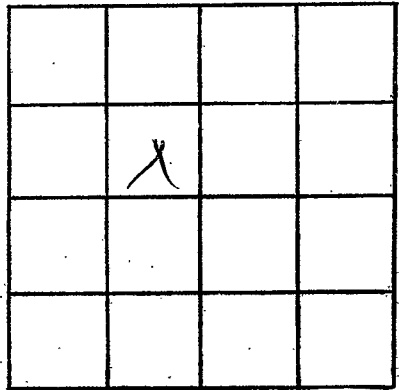

SECTION 8

Please indicate well location X.

ADDITIONAL INFORMATION

If more than one screen, show locations of each on sketch.