

Washington
 G 2014
 5-13-77

MISSISSIPPI
 BOARD OF WATER COMMISSIONERS
 416 North State Street
 151 Jackson, Mississippi 39201

WATER WELL DRILLERS LOG

13 May 1977 date well completed
 Lambert Drilling Wash firm name
 county well located


LANDOWNER:	description of formations encountered	from	to
Williams Hicks. Greenville, Miss. (mailing address)			
WELL LOCATION:	Sand & Gravel	120	130
sec. 26 T 17 N R 9 E 8 4 ¹ / ₂ miles SW of Greenville (distance) (direction) (nearest town)	Clay	130	205
WELL PURPOSE: home (home, irrigation, municipal, industrial)	Clay st Sand	205	385
WELL COMPLETION DATA:	Sand & tillite	385	430
(1) diameter (inches) 2	Sand & goot.	430	480
(2) total depth (feet) 450			
(3) static water level (feet) 36 below top of ground.			
(4) casing PVC 470 (material) (depth)			
(size) If telescope see back.			
(5) screen 10 480-470 (length) (depth to top)			
2" PVC. (size) (material)			
(6) pump 1 10 (HP) (yield gpm)			
elect (type power)			
(7) electric log (yes or no)			
(organization running log)			
(8) how well bottom plugged backwash			
DRILLERS REMARKS:			

RECEIVED
 JUN 29 1977

MISS. BU. OF WATER

If well telescopes please sketch and show depths.

GROUND LEVEL

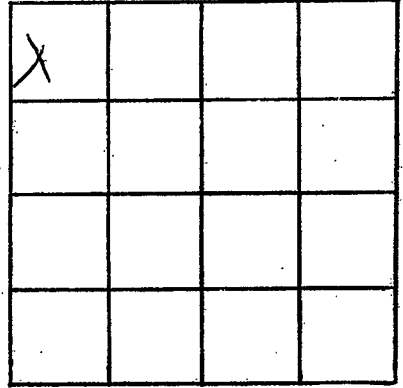

SECTION 20

Please indicate well location X.

ADDITIONAL INFORMATION

If more than one screen, show locations of each on sketch.