

WASHINGTON

G 2017

5-16-77

MISSISSIPPI BOARD OF WATER COMMISSIONERS  
416 North State Street  
Jackson, Mississippi 39201

WATER WELL DRILLERS LOG

5-16  
date well completed

1977  
Schultz Drilling  
firm name

Wash  
county well located

LANDOWNER:

Refuge Plantation

(mailing address)

WELL LOCATION:

sec. 5 T 12 N R 9 E  
6 miles 5-W of P.V.  
(distance) (direction) (nearest town)

WELL PURPOSE: Home  
(home, irrigation, municipal, industrial)

WELL COMPLETION DATA:

- (1) diameter (inches) 4 1/2
- (2) total depth (feet) 400
- (3) static water level (feet) 43 below top of ground.
- (4) casing P.V.C. (material) (depth) (size) if telescope see back.
- (5) screen 20 (length) (depth to top) (size) P.V.C. (material)
- (6) pump 1 (HP) 30 (yield gpm) (type power) E.C.E.
- (7) electric log (yes or no)

(organization running log)

(8) how well bottom plugged

DRILLERS REMARKS:

description of formations encountered

from

to

Top Soil	0	20
Sand	20	96
Clay	96	135
Sand	135	143
Shale + Sandstone	143	360
Sand	360	410


RECEIVED  
JUN 8 1977

MISS. BD. OF WATER COMMISSIONERS

If well telescopes please sketch and show depths.

GROUND LEVEL

4"  
1  
2"  
2  
30 ft  
Screen

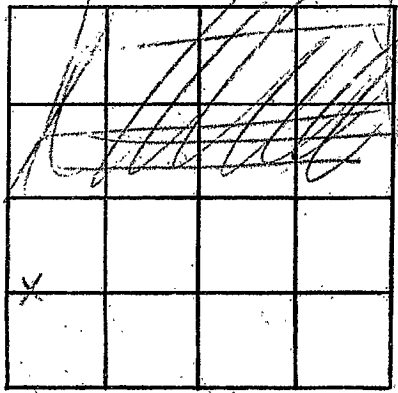

SECTION 5

Please indicate well location X.

ADDITIONAL INFORMATION

If more than one screen, show locations of each on sketch.