

WASHINGTON

G 2019

5-23-77

MISSISSIPPI BOARD OF WATER COMMISSIONERS
416 North State Street
Jackson, Mississippi 39201

WATER WELL DRILLERS LOG

5/23 1977
date well completed

151

Schultz Drilling
firm name

Washington
county well located

LANDOWNER:

P. H. Duquell

description of formations encountered

from

to

Rt. 2

Clay

0 23

Shawhill MS.
(mailing address)

Sand

23 70

WELL LOCATION:

sec 150 T 17 N R 9 E
4 miles S of P.V. (nearest town)

WELL PURPOSE:

(home, irrigation, municipal, industrial)
Home

WELL COMPLETION DATA:

- (1) diameter (inches) 2"
- (2) total depth (feet) 65
- (3) static water level (feet) 16 below top of ground
- (4) casing P.V.C. (material), (depth), (size) if telescope see back.
- (5) screen 5 (length), (depth to top) 2" (size), P.V.C. (material)
- (6) pump None (HP), (yield gpm)
- (7) electric log (yes or no)

(organization running log)

(8) how well bottom plugged Coy


DRILLERS REMARKS:

RECEIVED
JUN 8 1977

MISS. Bd. OF WATER COMMISSIONERS

If well telescopes please sketch and show depths.

GROUND LEVEL

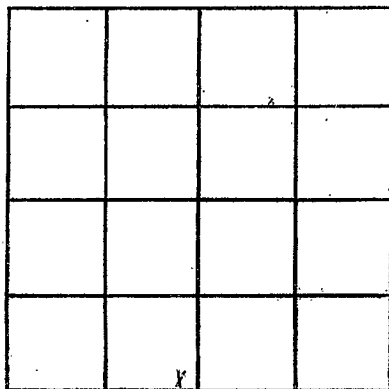

SECTION 15

Please indicate well location X.

ADDITIONAL INFORMATION

If more than one screen, show locations of each on sketch.