

Washington  
 B 2024  
 11/2/77

MISSISSIPPI  
 BOARD OF WATER COMMISSIONERS  
 416 North State Street  
 Jackson, Mississippi 39201

WATER WELL DRILLERS LOG

2 Nov. 1977 Lambert Drilling Wash  
 date well completed firm name county well located


LANDOWNER:	description of formations encountered	from	to
Bob Lyon Greenville, Miss. (mailing address)			
WELL LOCATION: sec. 8 T. 17 N. R. 8 E. 5 miles S/E of Greenville (distance) (direction) (nearest town)	Sand.	30	60
WELL PURPOSE: HOME (home, irrigation, municipal, industrial)	Sand & gravel	60	97
WELL COMPLETION DATA: (1) diameter (inches) 2	Clay Shell	98	205
(2) total depth (feet) 440	Clay	205	220
(3) static water level (feet) 41 below top of ground.	rock.	220	222
(4) casing PVC 430 (material) (depth)	Clay st sand.	222	282
(size) if telescope see back.	rock.	282	282
(5) screen 10 (length) 440-430 (depth to top)	Sand st clay	282	405
2" PVC (size) (material)	Sand.	405	440
(6) pump 1 (HP) 16 (yield gpm)			
elect (type power)			
(7) electric log <input checked="" type="checkbox"/> (yes or no)			
(organization running log)			
(8) how well bottom plugged back wash			
DRILLERS REMARKS:			

RECEIVED  
 DEC 9 1977

MISS. BD. OF WATER COMMISSIONERS

If well telescopes please sketch and show depths.

GROUND LEVEL

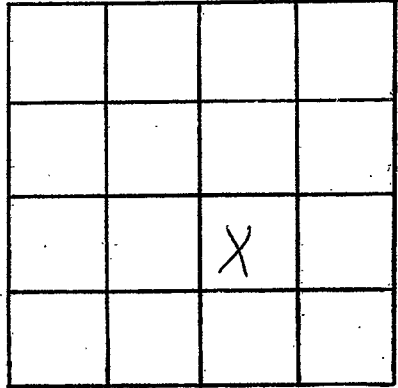

SECTION 8

Please indicate well location X.

ADDITIONAL INFORMATION

If more than one screen, show locations of each on sketch.